



--- UNDERGROUND
— AERIAL

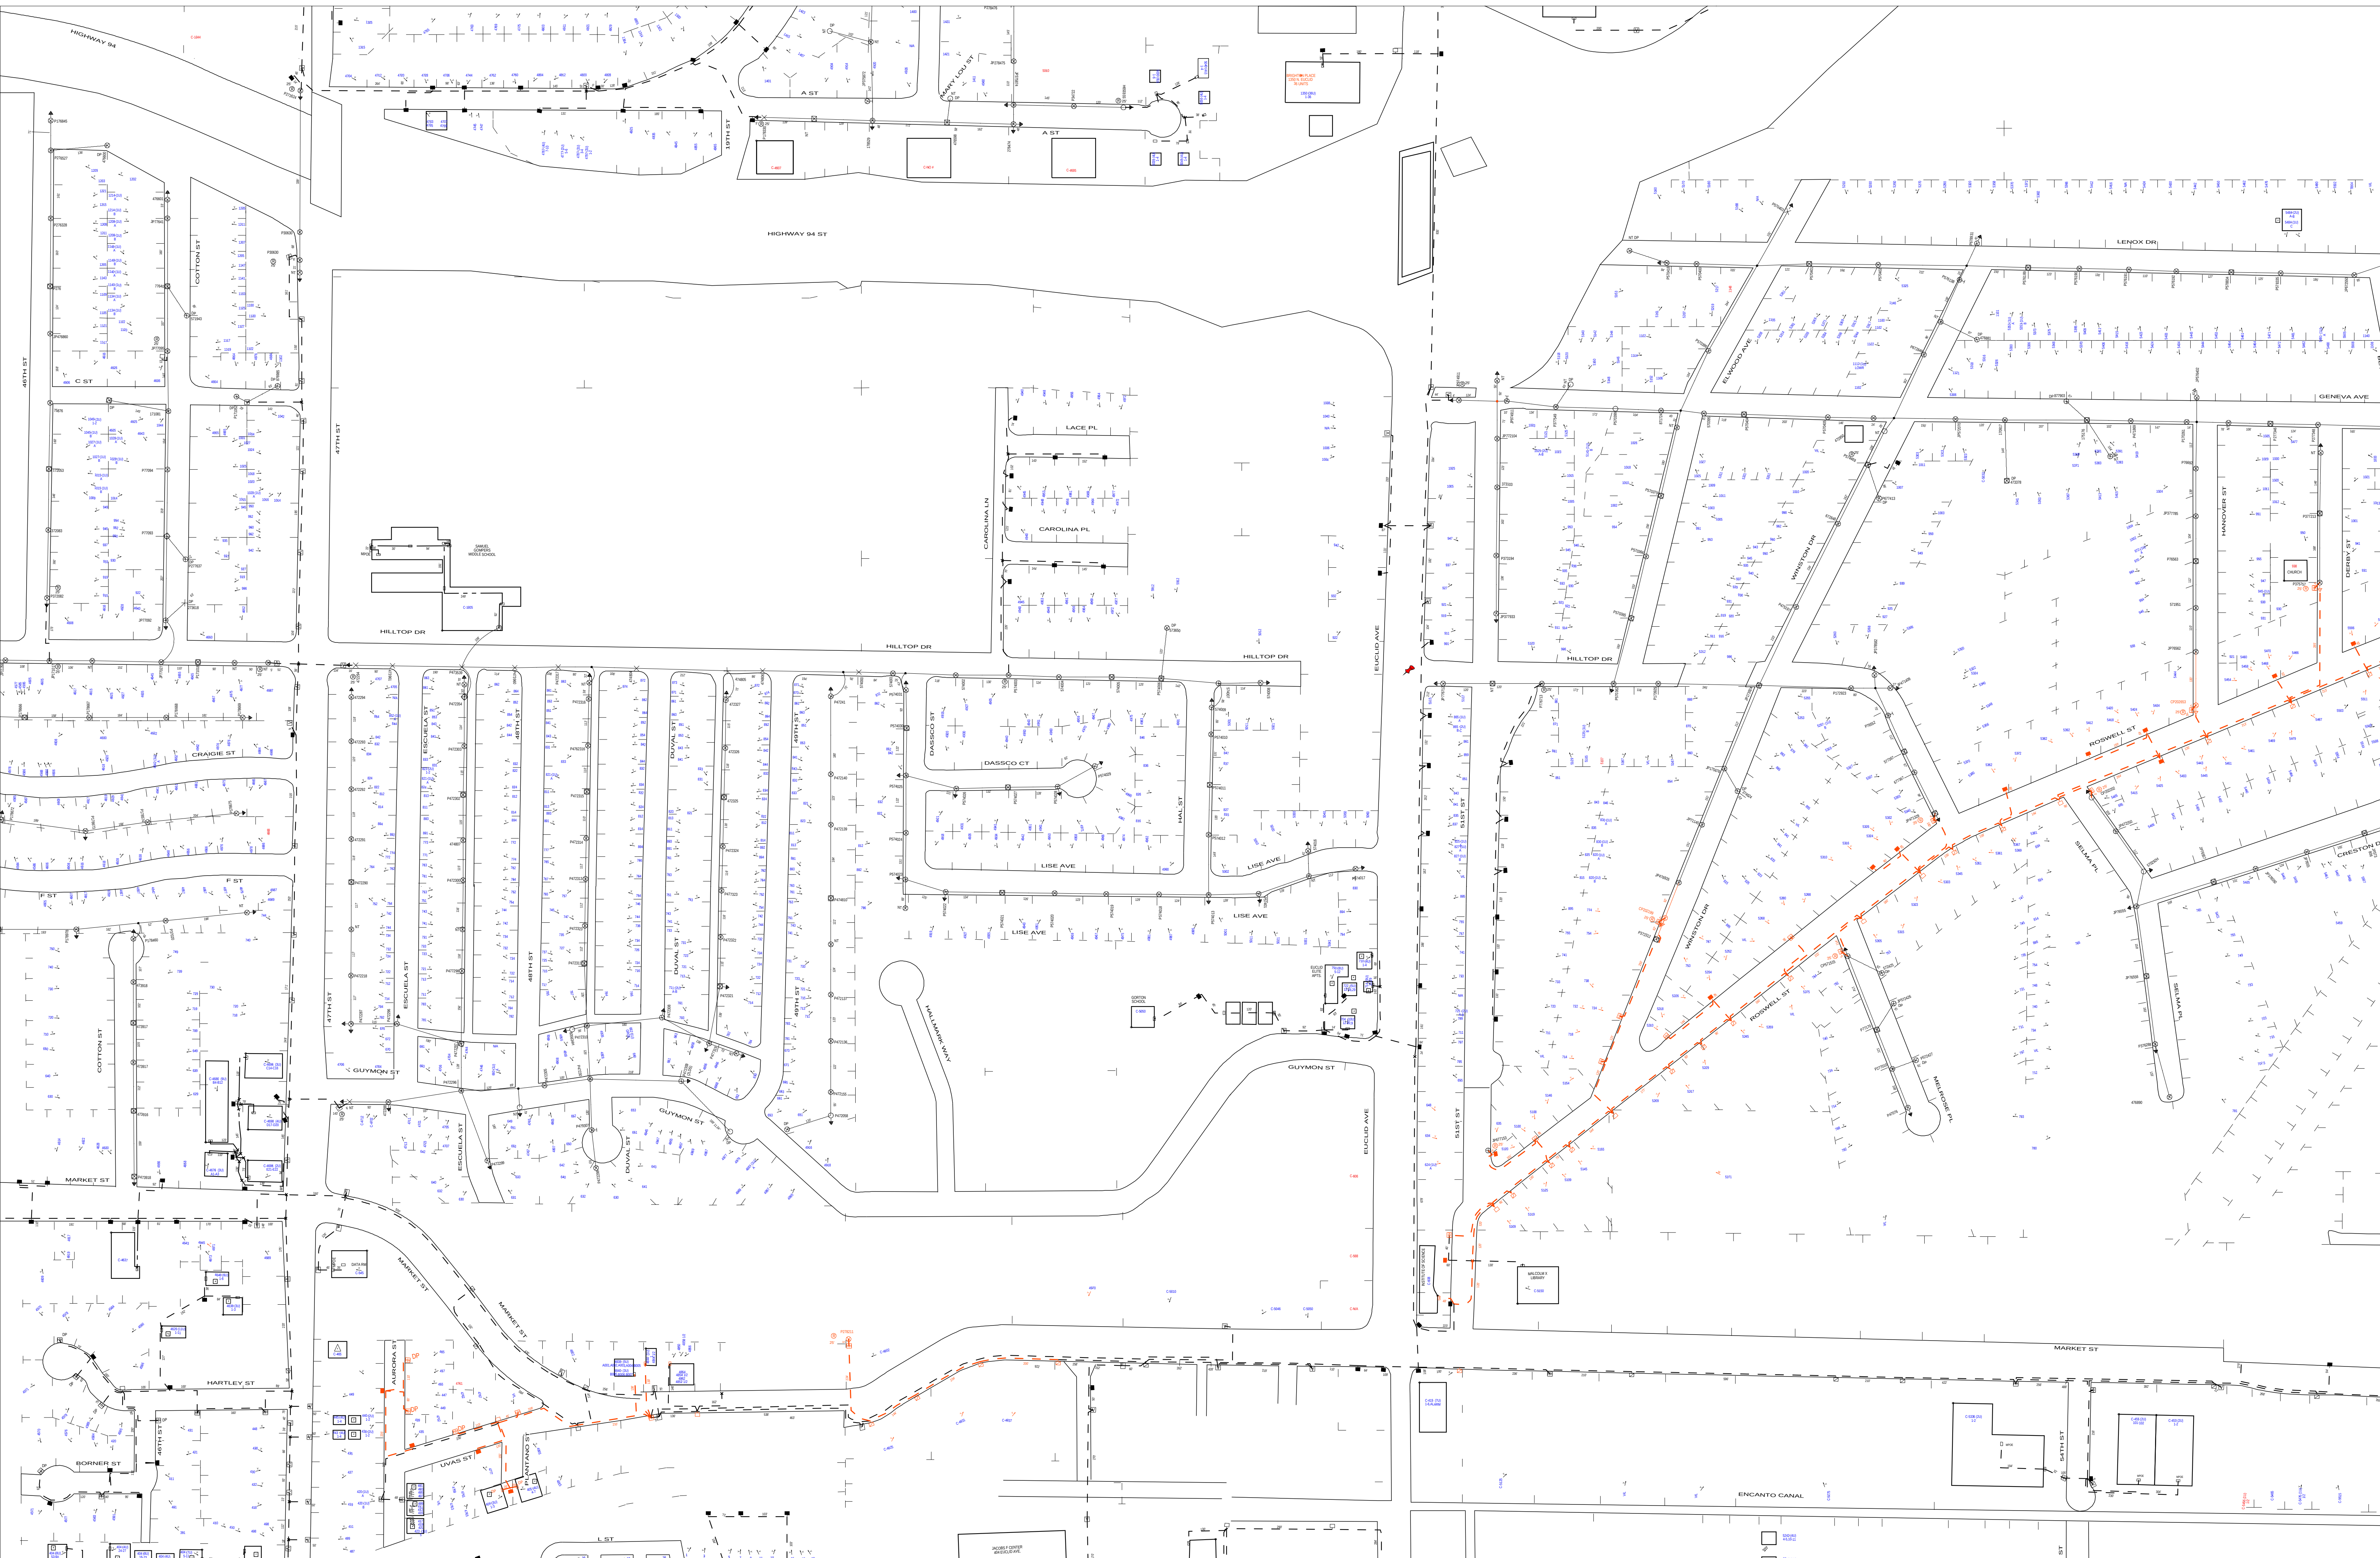

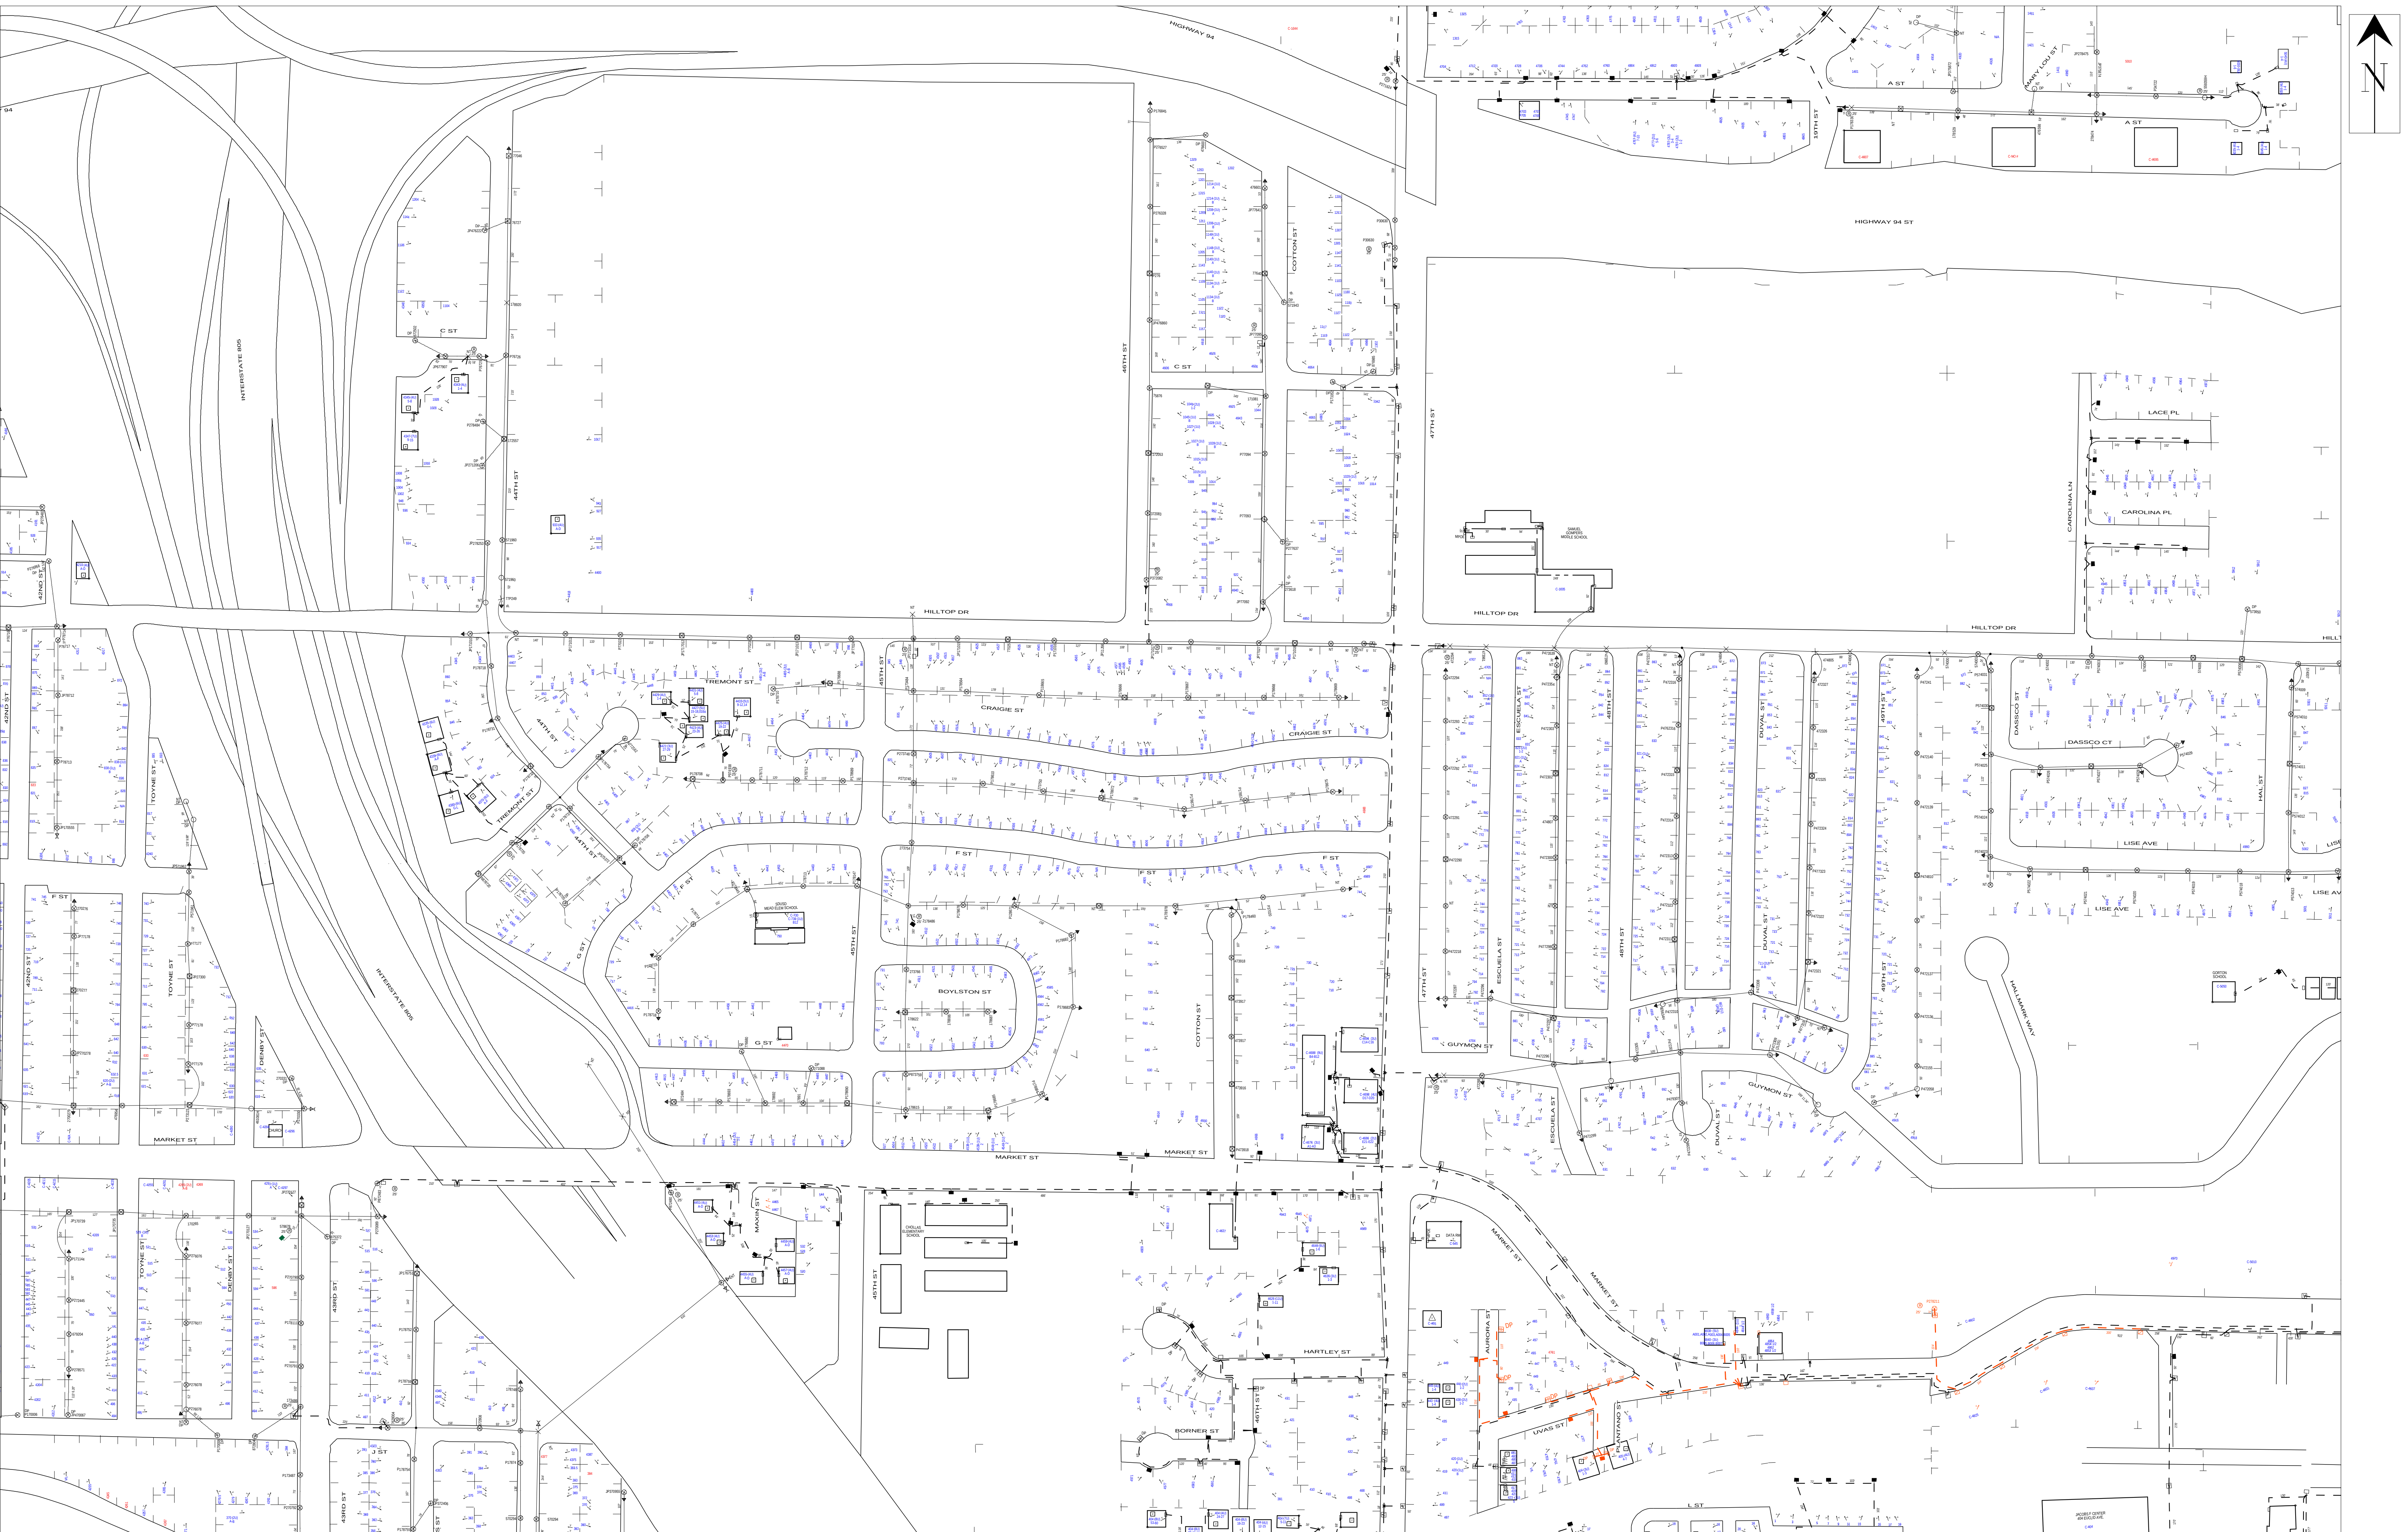

----- UNDERGROUND
----- AERIAL