


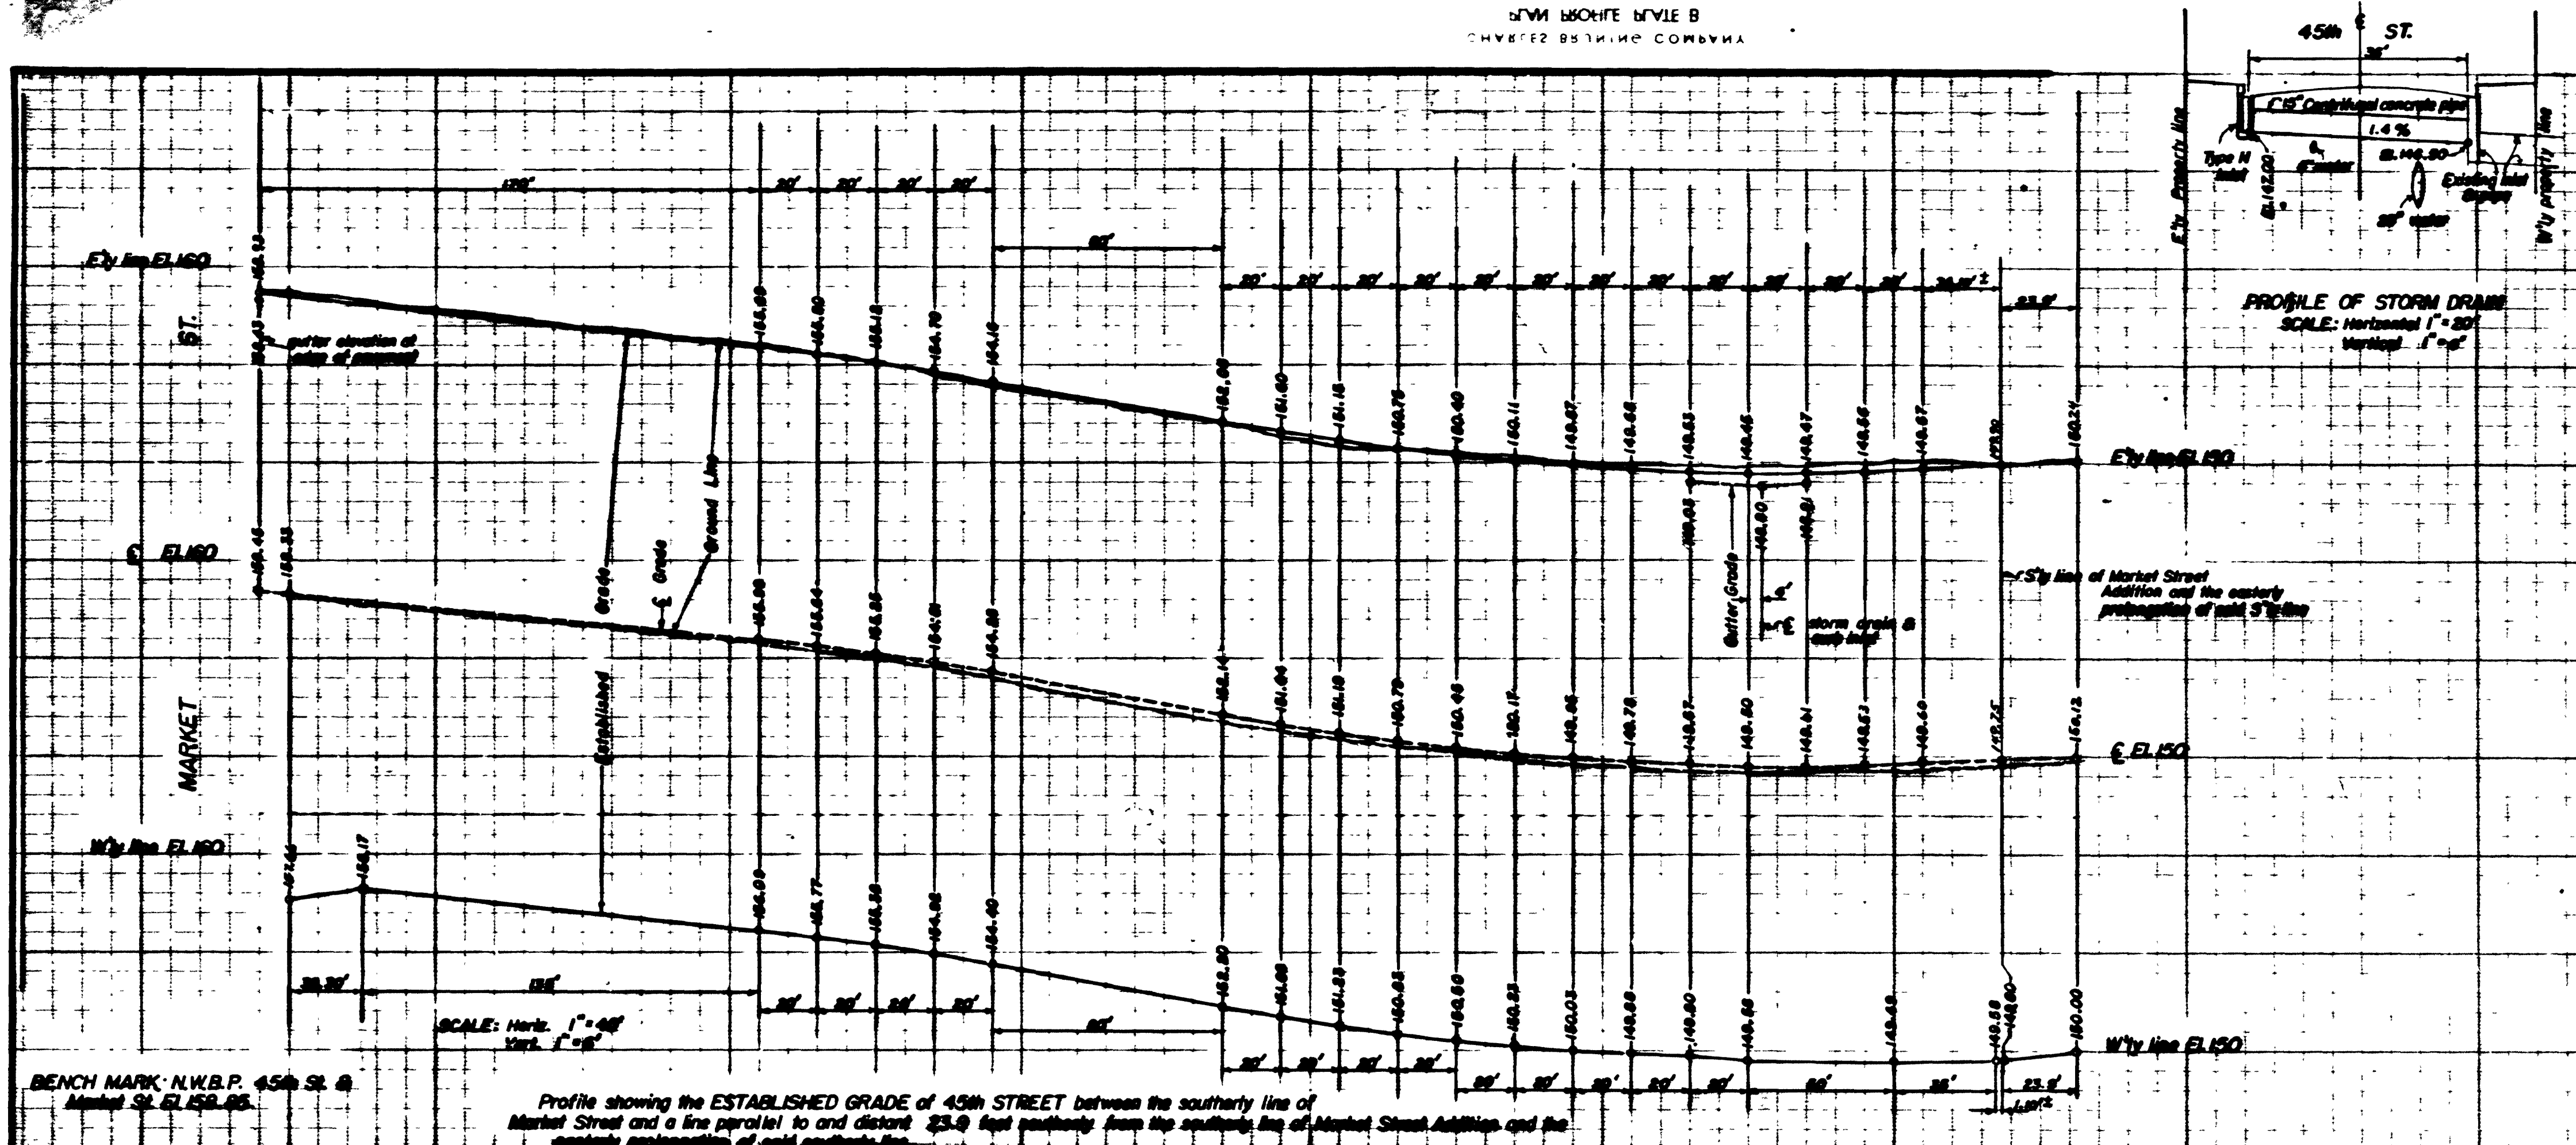

WORK TO BE DONE

The improvement consists of the following work to be done according to these plans and the specifications hereto attached:

- The grading of the portion of the street shown hatched thus.
- The preparation of subgrade and paving of the portion of the street shown shaded thus.
- The construction of type 6 curb shown thus.
- The construction of curb inlet shown thus.
- The construction of 15" centrifugal concrete pipe storm drain shown thus.
- The construction of commercial driveway shown thus.
- The construction of sidewalk shown thus.
- The re-location of existing fire hydrant as shown on the plan.
- The raising of existing sewer manhole as shown on the plan.

LEGEND - EXISTING WORK

Curb	Water main
Sidewalk	Gate valve
Sanitary sewer	Fire hydrant
Manhole	Power pole
Inlet	Anchor pole or dead man
Storm drain	Edge of pavement
Gas main	


STANDARD DRAWINGS

4-S-8 (6-30-53)	303-S-8
9-S-8 (5-17-54)	305-S-8
24-S-8 (7-15-53)	309-S-8
108-S-8 (1-11-54)	313-S-8

SPECIAL NOTE

RE-LOCATE FIRE HYDRANT

The re-location of fire hydrant shown on this plan may be made by the Water Department of the City of San Diego for the following price, to wit: \$100.00

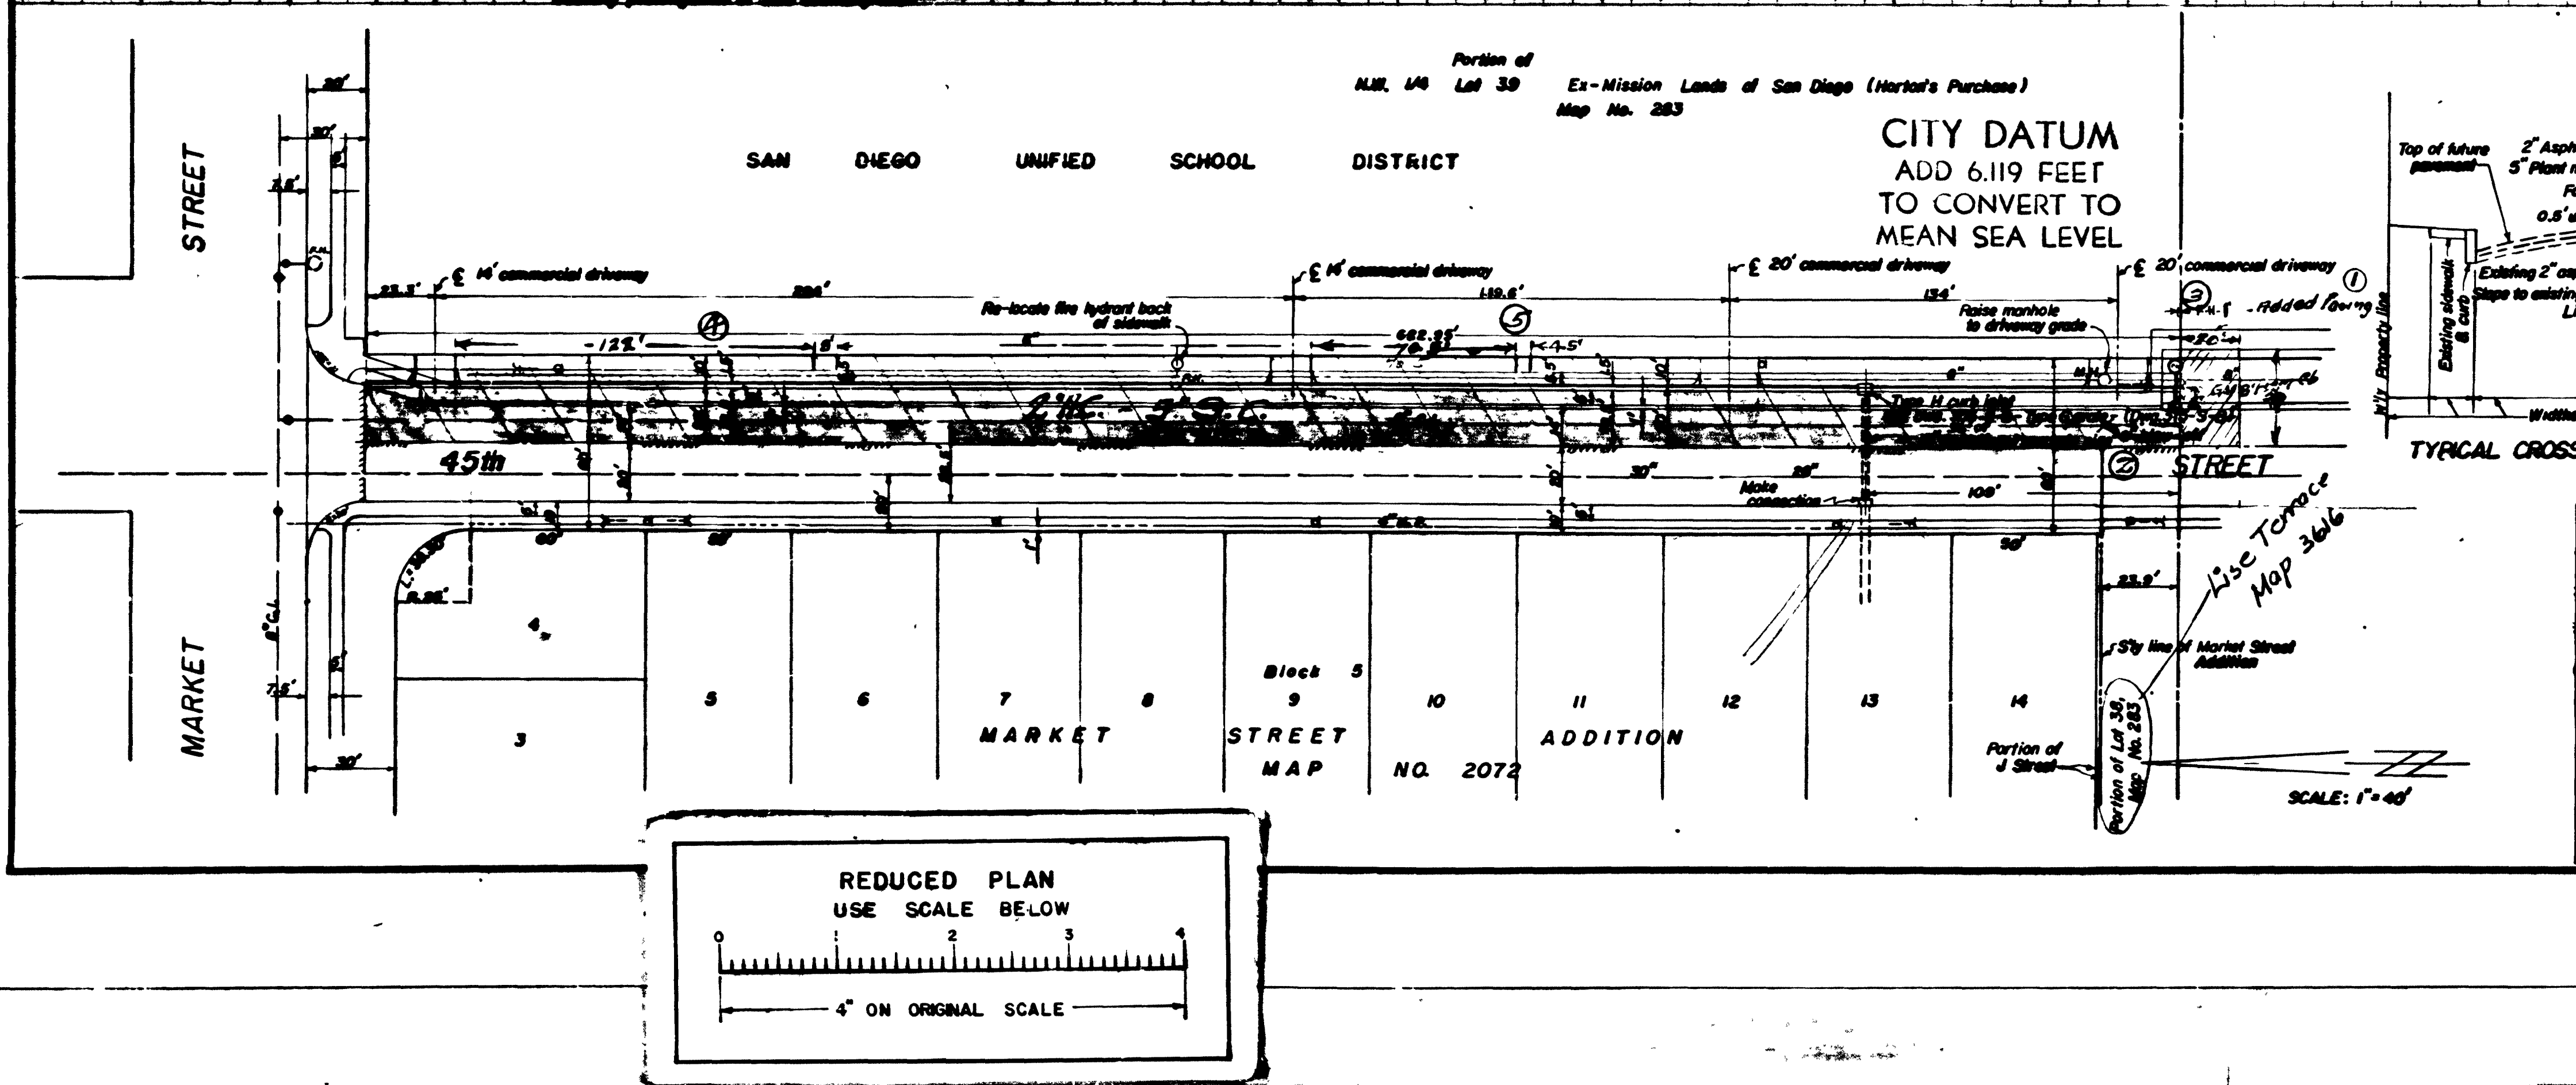

TYPICAL CROSS SECTION OF 45th STREET

Top of future pavement
2" Asphalt concrete surface course
5" Plant mixed compact treated base
For elevations see profile
0.5' unless shown otherwise

Existing 2" asphalt concrete surfacing
Steps to existing surfacing
Existing curb
Existing sidewalk
Class A subgrade

sidewalk
Type 6 curb
curb line
Property line

CITY CONTRACT

CITY OF SAN DIEGO
ENGINEERING DEPARTMENT

Plans for the improvement of 45th STREET between the southerly line of Market Street and a line parallel to and distant 23.9 feet south of the southerly line of Market Street Addition and the easterly prolongation of said southerly line.

APPROVED: *A.K. Foy*
CITY ENGINEER

DATE: 5/17/54
SCALE: AS SHOWN

DRAWING NUMBER: 11467-L

CONSTRUCTION RECORD

CONTRACTOR: Dennis	INSPECTOR: Hikin
DATE STARTED: 8-13-54	REVISION: 5
DATE COMPLETED: 9-28-54	DATE: 5-17-54

W O No. 68660-62925

MICROFILMED
APR - 1963