


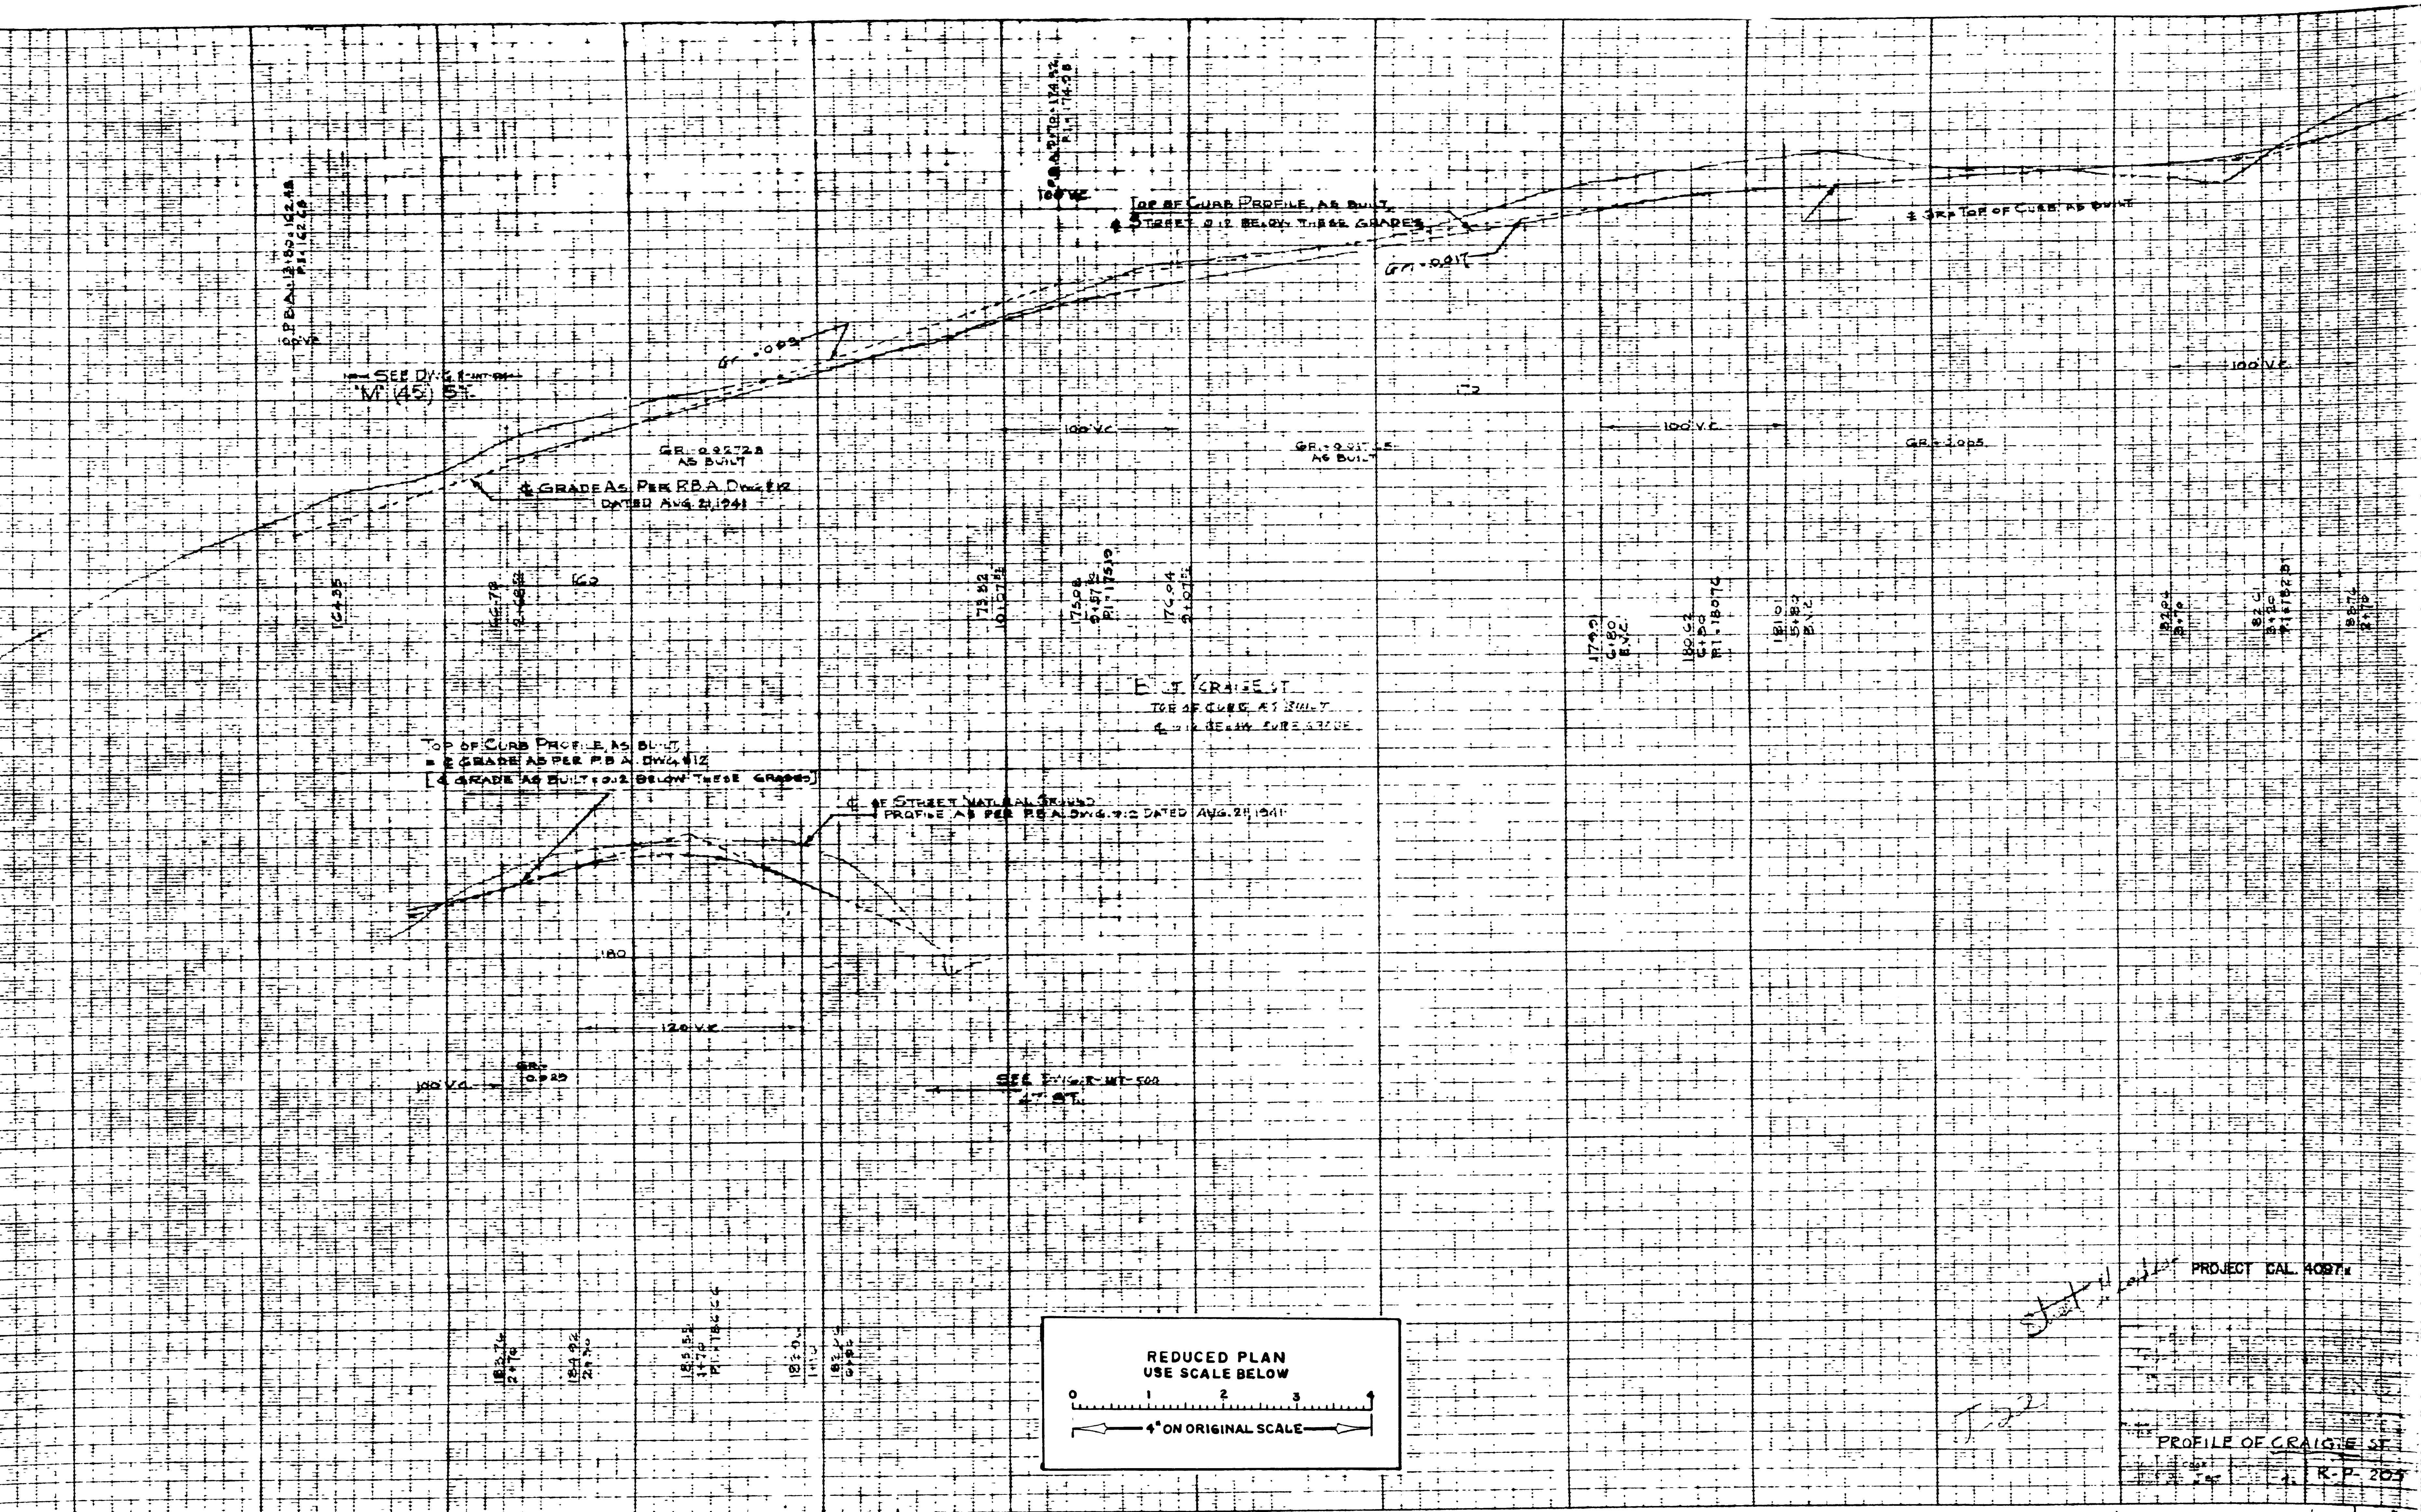

1376-1