


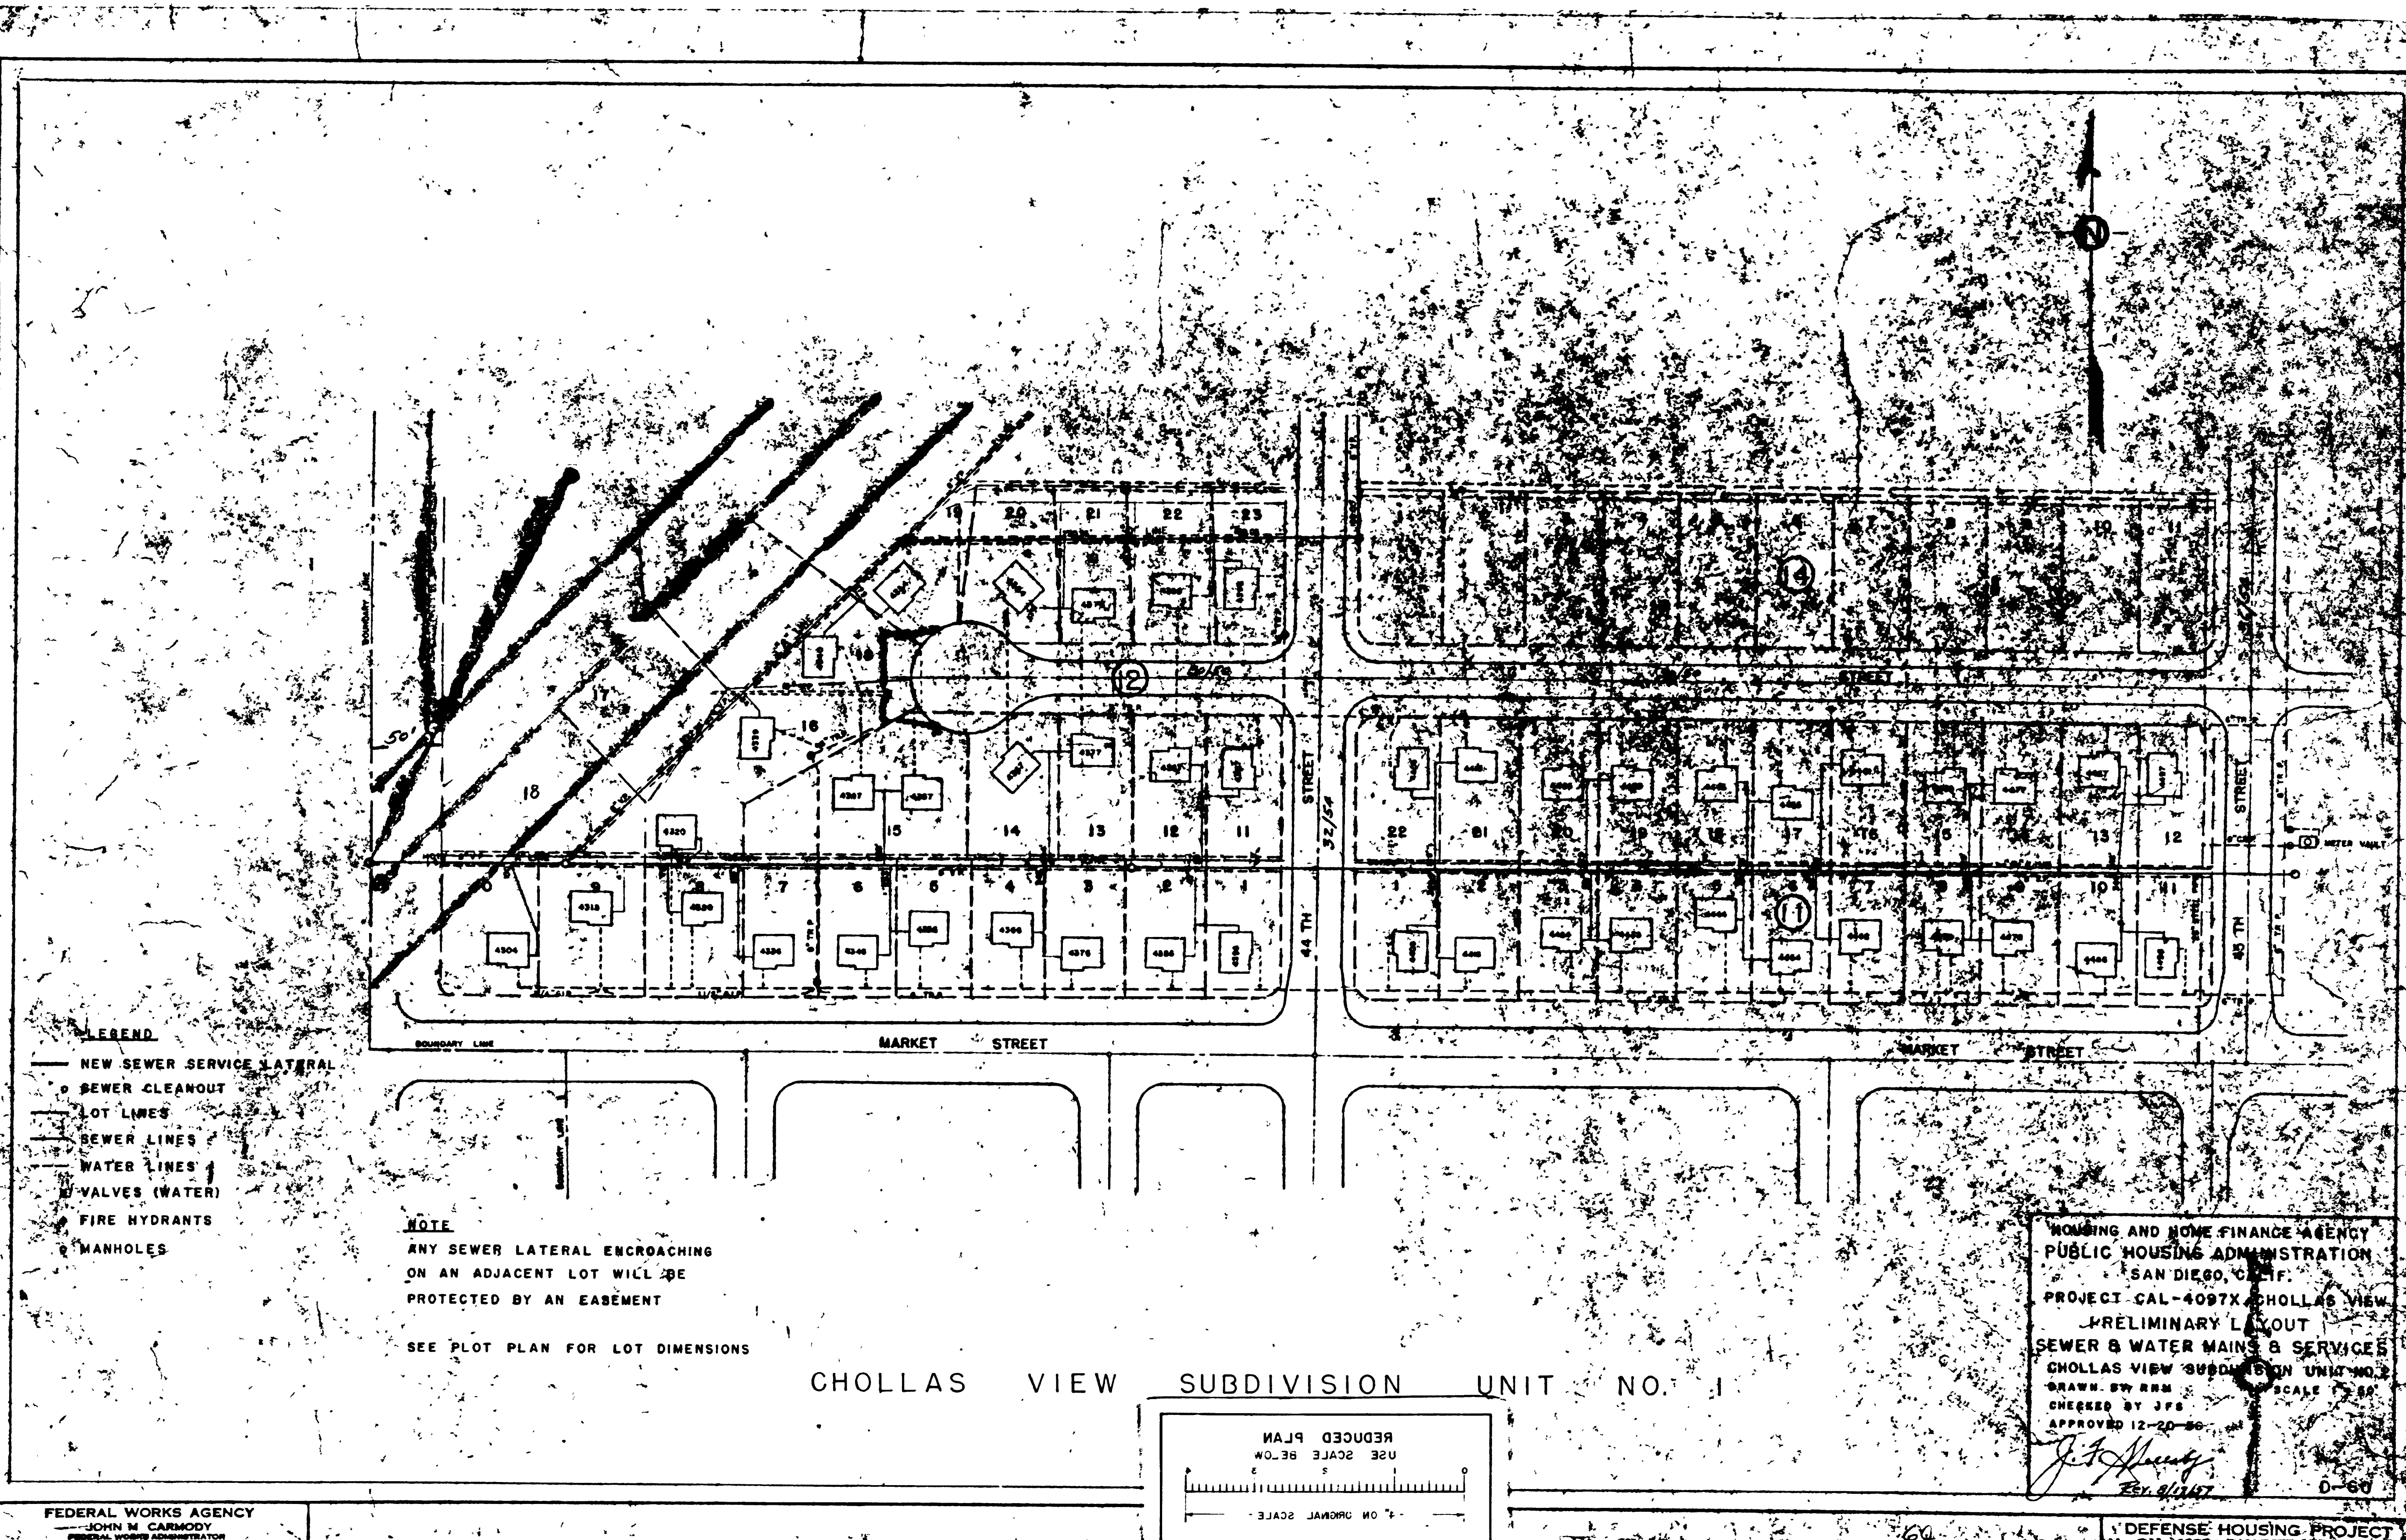


- LEGEND**
- NEW SEWER SERVICE LATERAL
 - SEWER CLEANOUT
 - LOT LINES
 - SEWER LINES
 - WATER LINES
 - VALVES (WATER)
 - FIRE HYDRANTS
 - MANHOLES

NOTE
ANY SEWER LATERAL ENCROACHING
ON AN ADJACENT LOT WILL BE
PROTECTED BY AN EASEMENT
SEE PLOT PLAN FOR LOT DIMENSIONS

CHOLLAS VIEW SUBDIVISION UNIT NO. 1

HOUSING AND HOME FINANCE AGENCY
PUBLIC HOUSING ADMINISTRATION
SAN DIEGO, CALIF.
PROJECT CAL-4097X CHOLLAS VIEW
PRELIMINARY LAYOUT
SEWER & WATER MAINS & SERVICES
CHOLLAS VIEW SUBDIVISION UNIT NO. 1
DRAWN BY RRM
CHECKED BY JFS
APPROVED 12-20-56
J. F. Smith
Rev. 9/1/47
D-60

FEDERAL WORKS AGENCY
JOHN M. CARMODY
FEDERAL WORKS ADMINISTRATOR

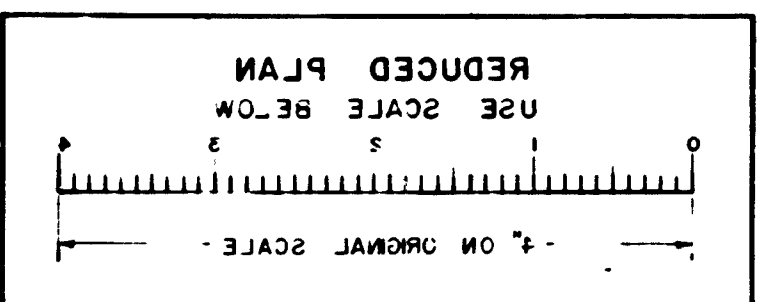

DEFENSE HOUSING PROJECT