



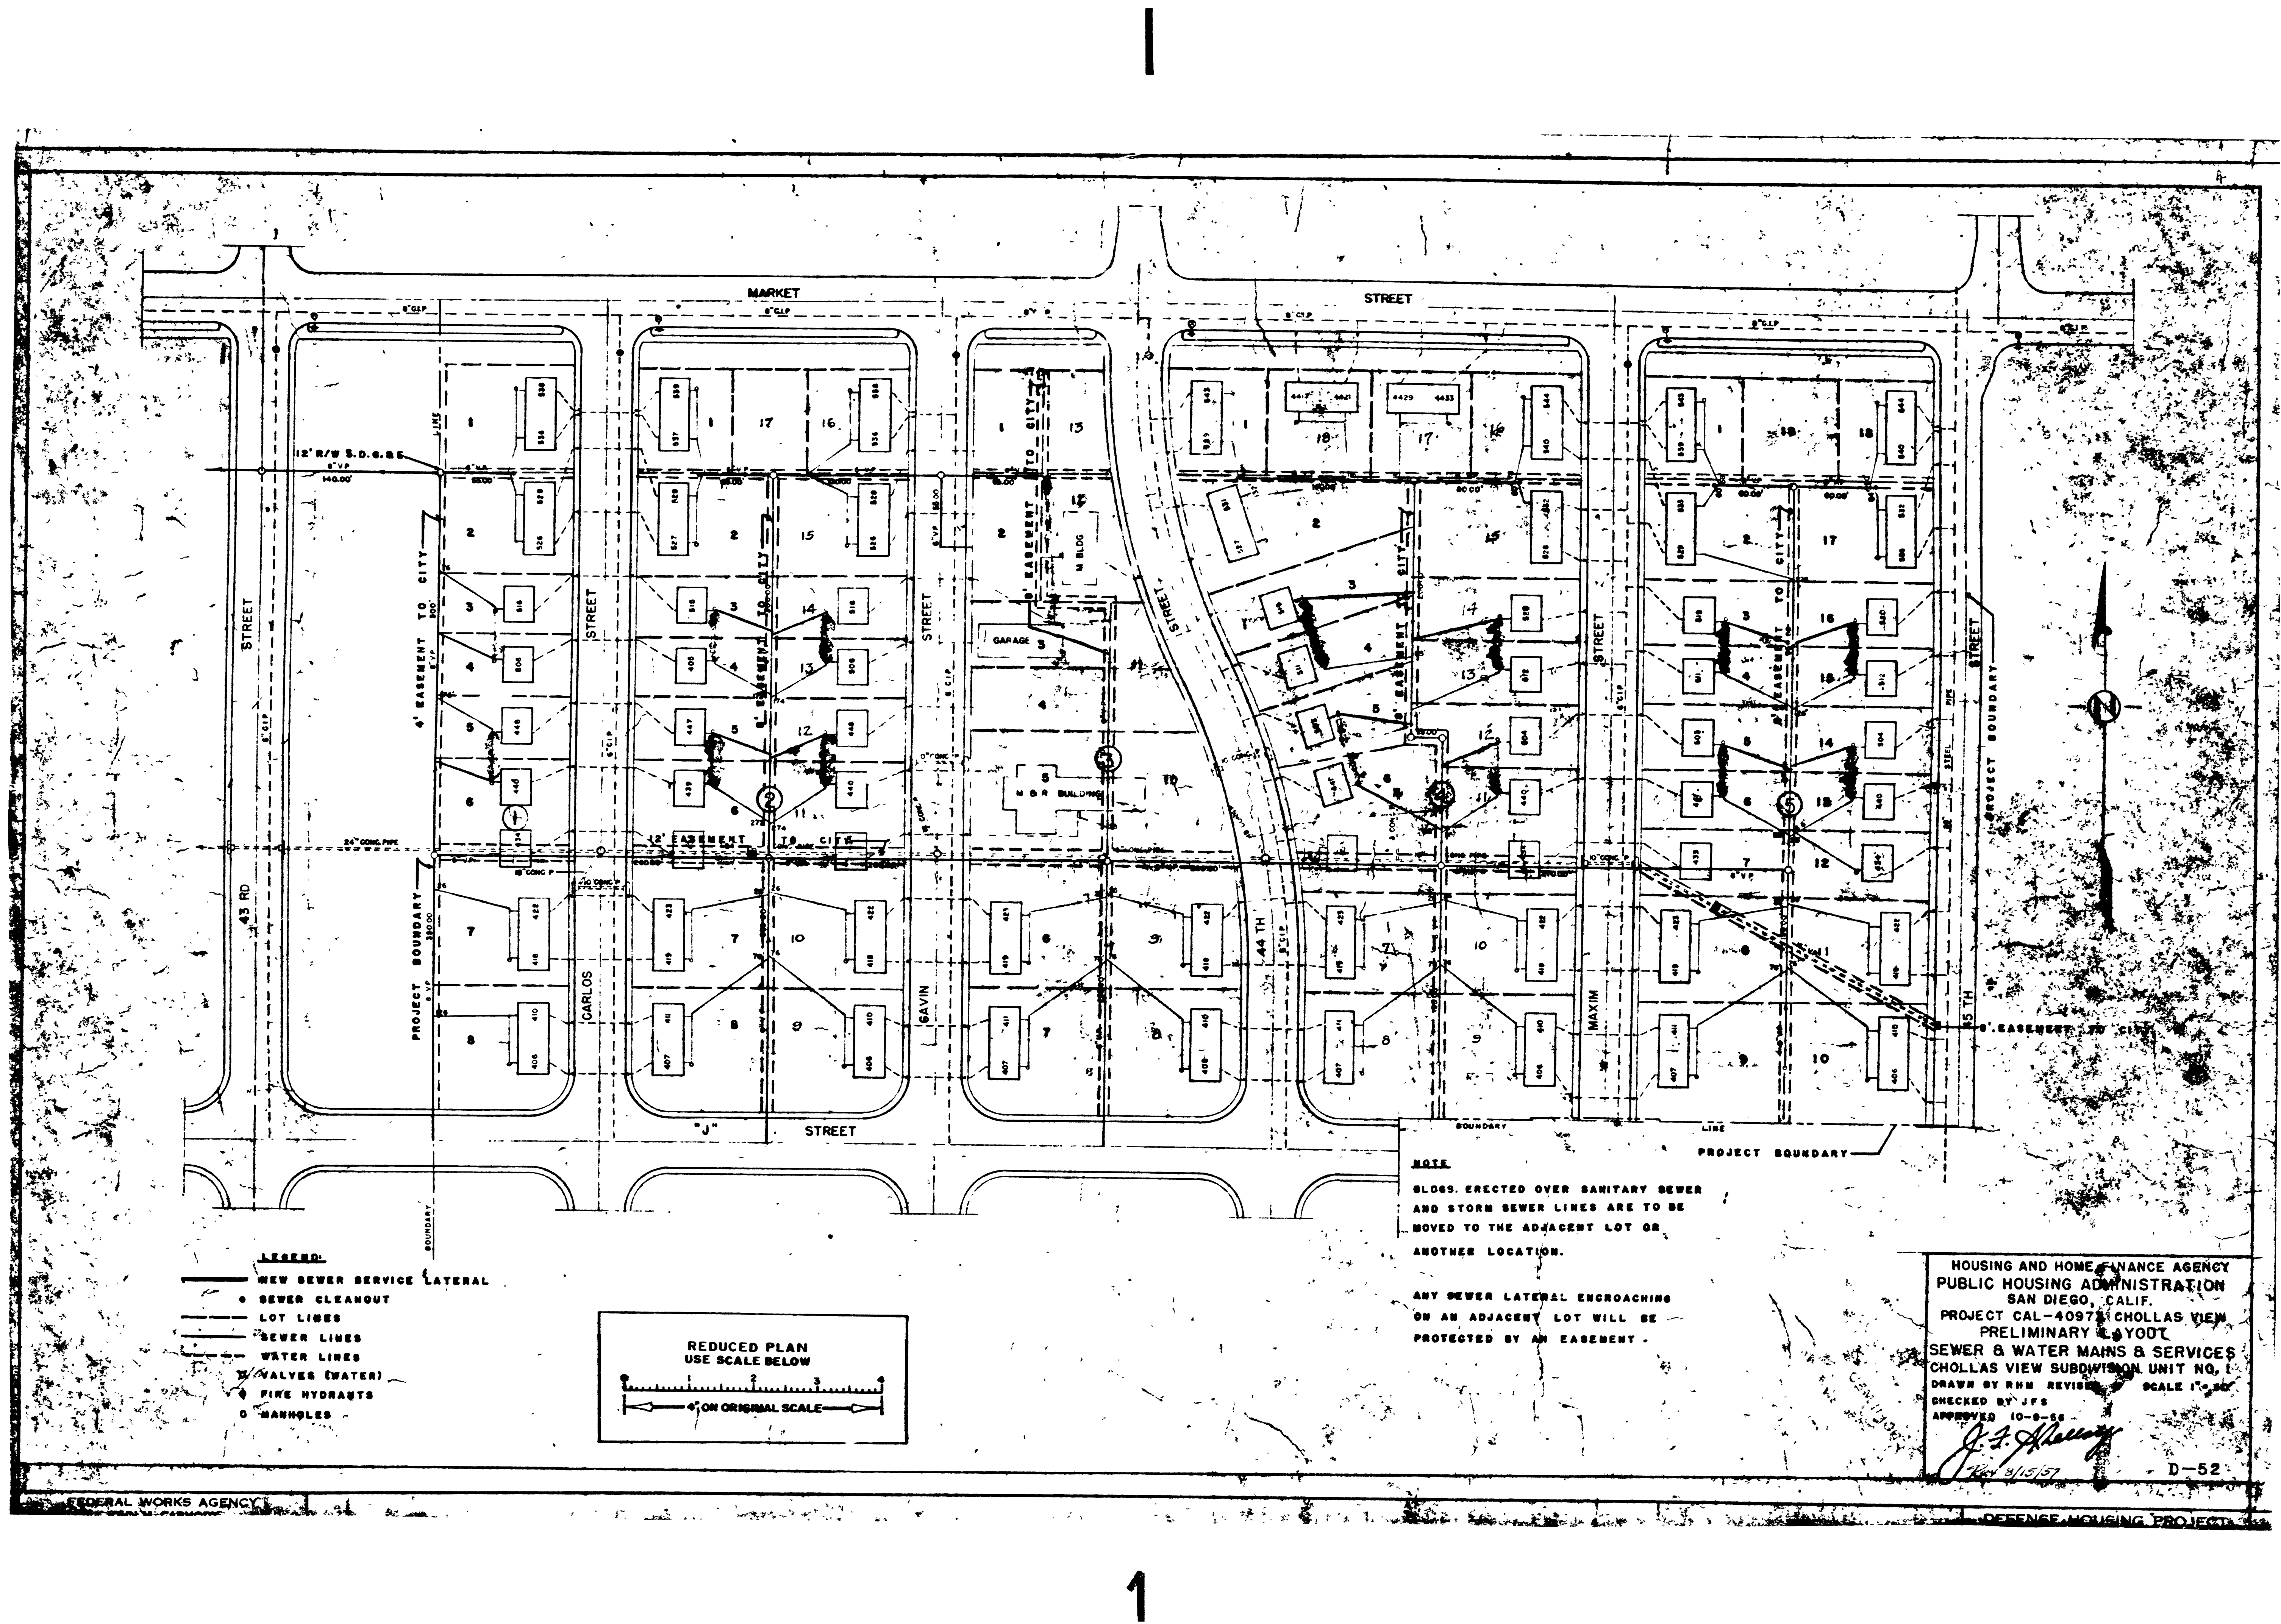

LEGEND:

- NEW SEWER SERVICE LATERAL
- SEWER CLEANOUT
- LOT LINES
- SEWER LINES
- WATER LINES
- VALVES (WATER)
- FIRE HYDRANTS
- MANHOLES

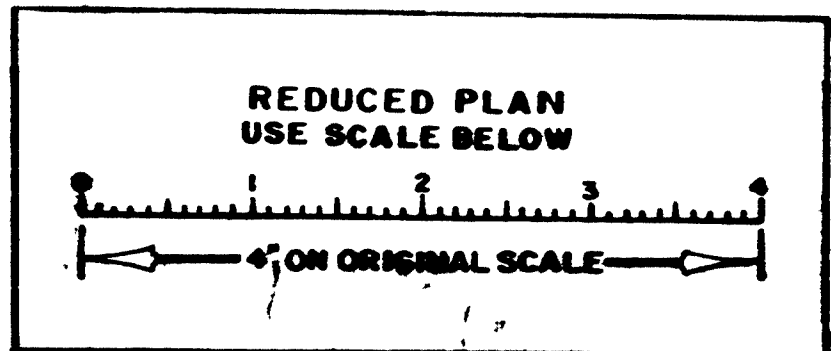

NOTE

BLOCKS ERRECTED OVER SANITARY SEWER
AND STORM SEWER LINES ARE TO BE
MOVED TO THE ADJACENT LOT OR
ANOTHER LOCATION.

ANY SEWER LATERAL ENCRANCHING
ON AN ADJACENT LOT WILL BE
PROTECTED BY AN EASEMENT.

HOUSING AND HOME FINANCE AGENCY
PUBLIC HOUSING ADMINISTRATION
SAN DIEGO, CALIF.
PROJECT CAL-4097 CHOLLAS VIEW
PRELIMINARY 1960
SEWER & WATER MAINS & SERVICES
CHOLLAS VIEW SUBDIVISION UNIT NO. 1
DRAWN BY RHM REVISION SCALE 1" = 40'
CHECKED BY JFS
APPROVED 10-9-57
J. F. S.
8/15/57