
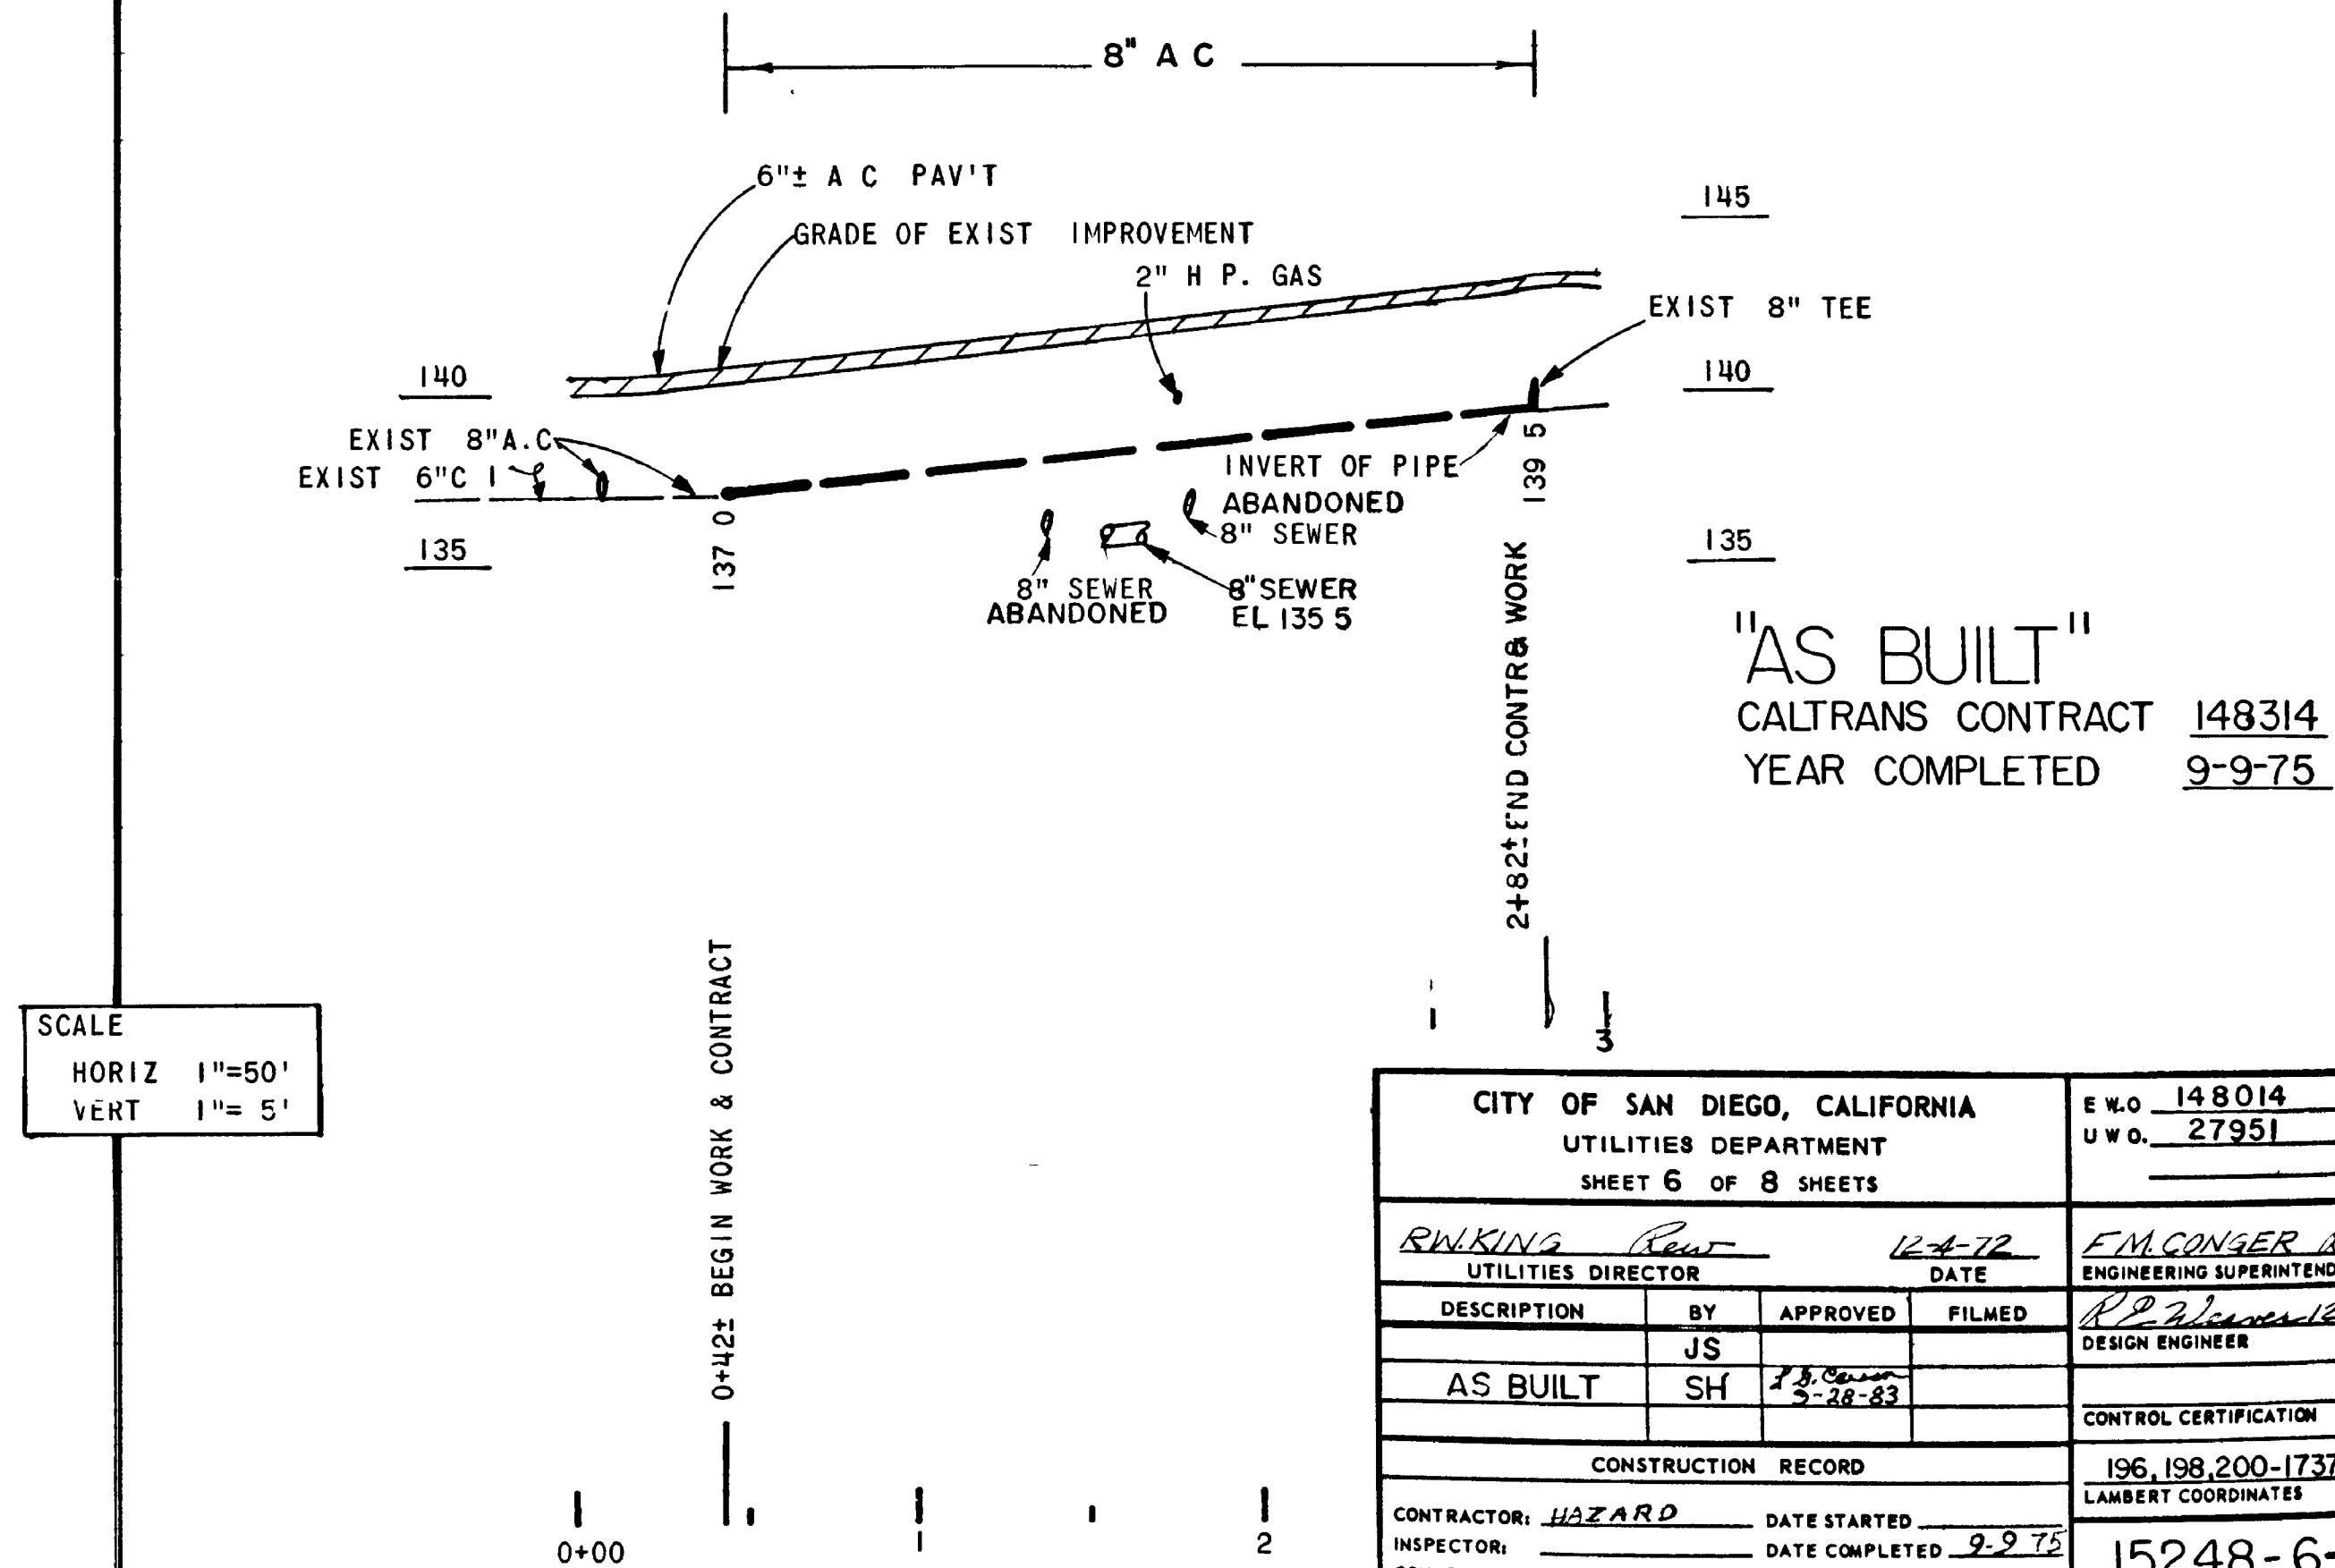


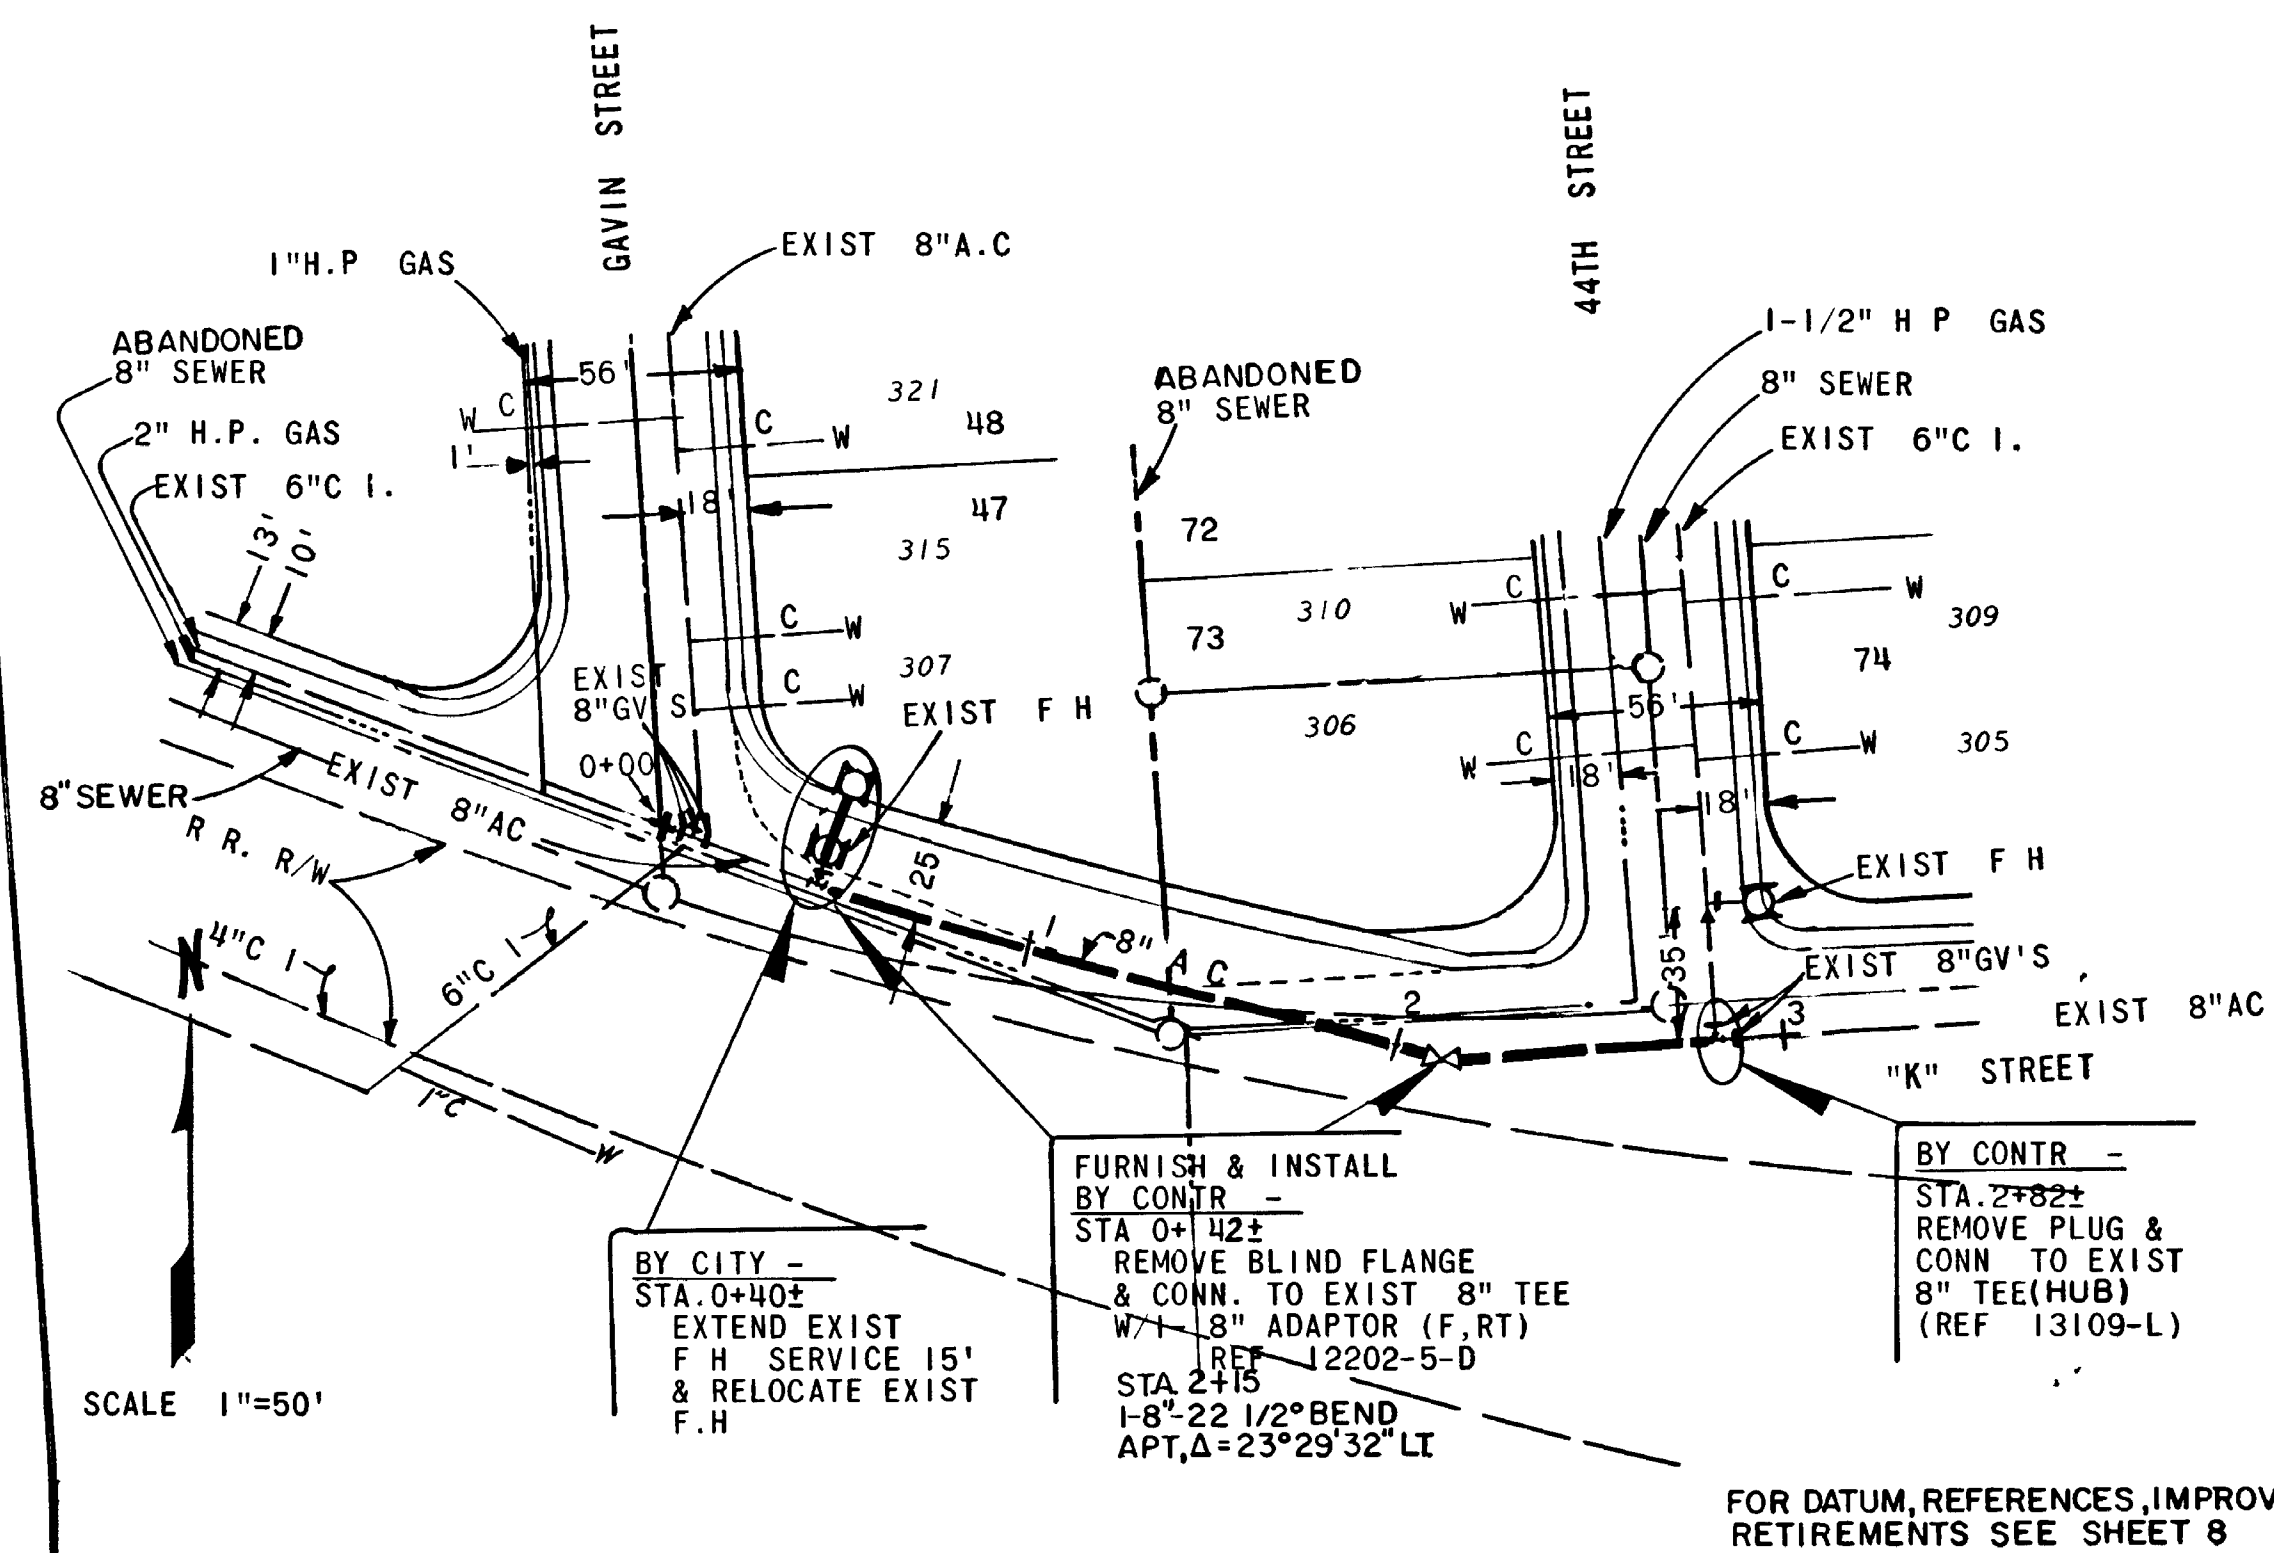

1-805 0.1 MI. NO OF IMPERIAL AVE. TO 01 MI. SO. OF SR 94