


APPROVED  
 DISTRICT ENGINEER  
 REGISTERED CIVIL ENGINEER NO.

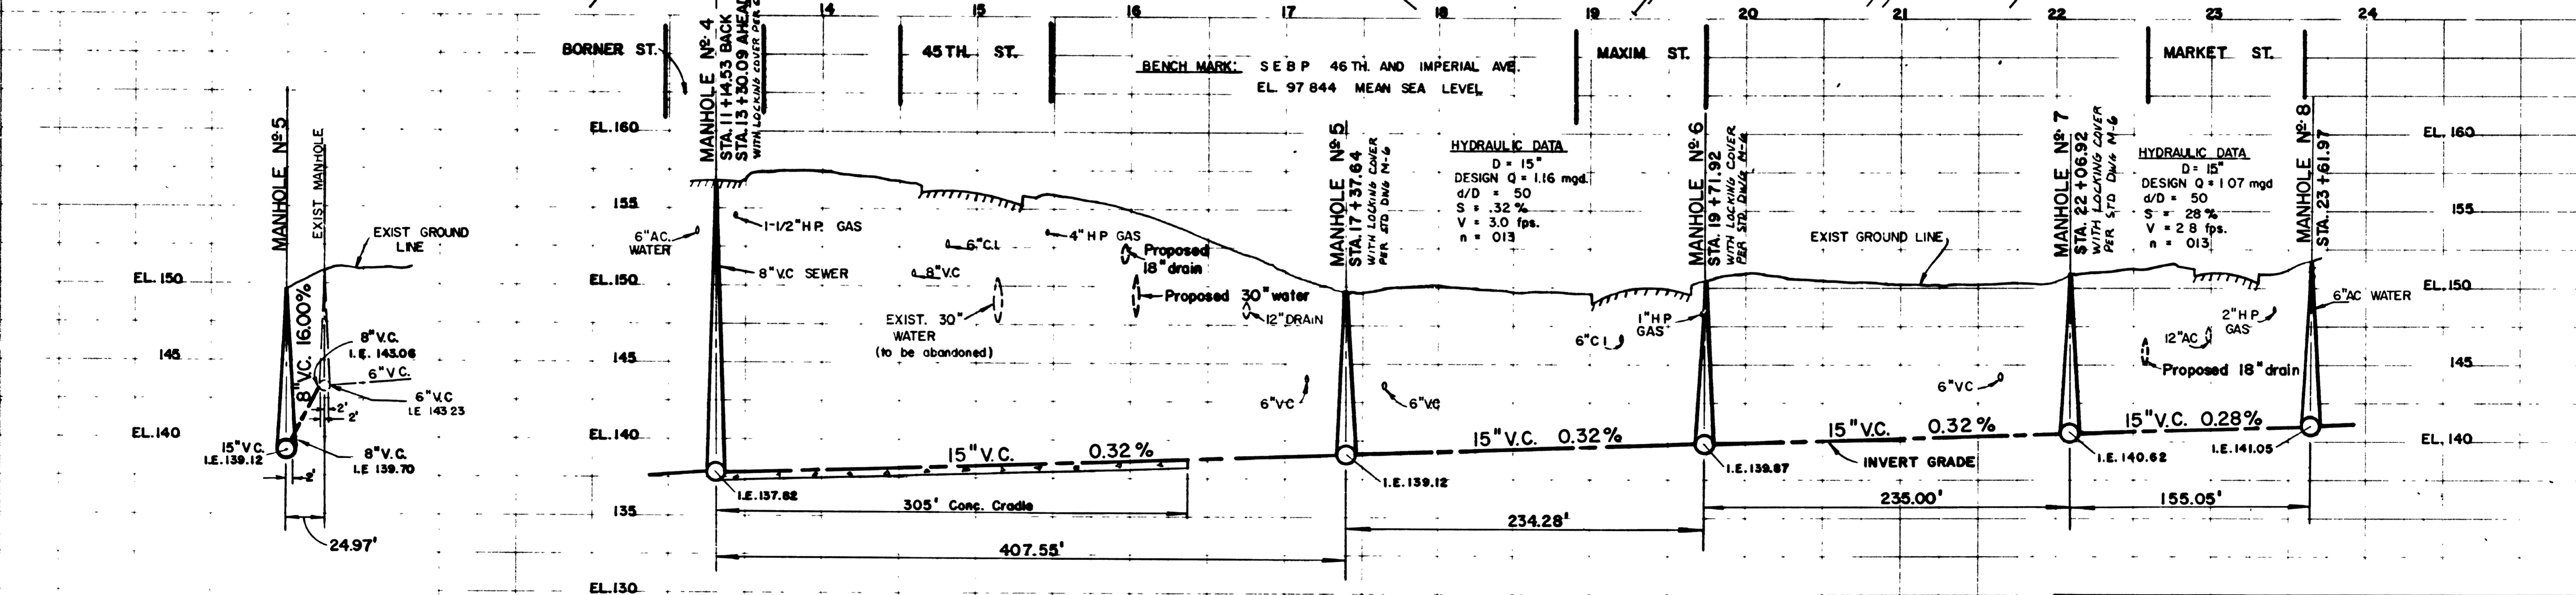

SEWER PROFILE  
 SCALE: HORIZONTAL 1" = 50'  
 VERTICAL 1" = 5'

"AS BUILT"  
 CALTRANS CONTRACT 148314  
 YEAR COMPLETED 9-9-75

CITY OF SAN DIEGO, CALIFORNIA UTILITIES DEPARTMENT	
SEWER REALIGNMENT ALONG I-805 FROM 45TH. ST. TO MARKET ST.	
<i>R. KING</i> UTILITIES DIRECTOR 12-4-75 DATE	E.W.O. 147016 U.W.O. 60881
AS BUILT - FULLER APPROVED <i>Rob Cannon</i> DATE 2-14-83	15391-3-D