



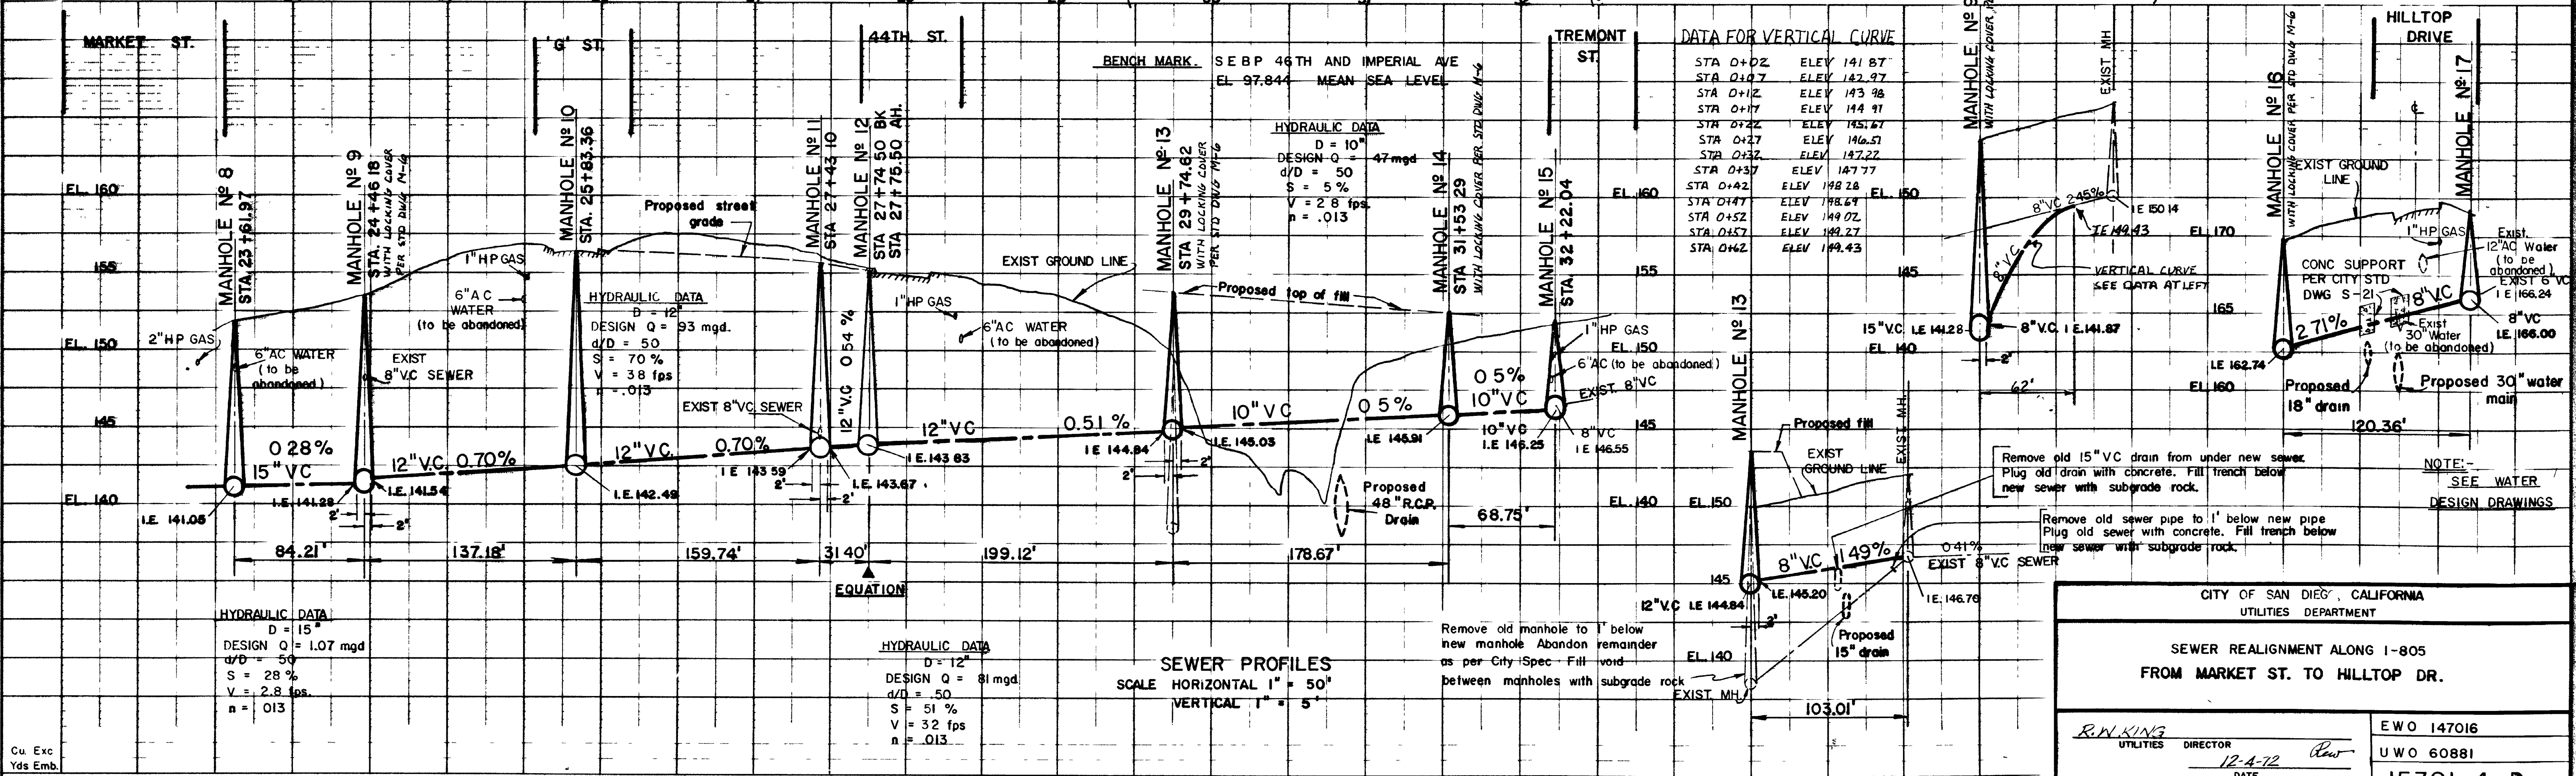

|                                                                 |  |                              |  |  |
|-----------------------------------------------------------------|--|------------------------------|--|--|
| CITY OF SAN DIEGO, CALIFORNIA<br>UTILITIES DEPARTMENT           |  |                              |  |  |
| SEWER REALIGNMENT ALONG I-805<br>FROM MARKET ST. TO HILLTOP DR. |  |                              |  |  |
| R. W. KING<br>UTILITIES DIRECTOR                                |  | EWO 147016<br>UWO 60881      |  |  |
| DATE 12-4-72                                                    |  | 15391-4-D                    |  |  |
| AS BUILT - FULLER                                               |  | APPROVED 2-8-83 DATE 2-14-83 |  |  |

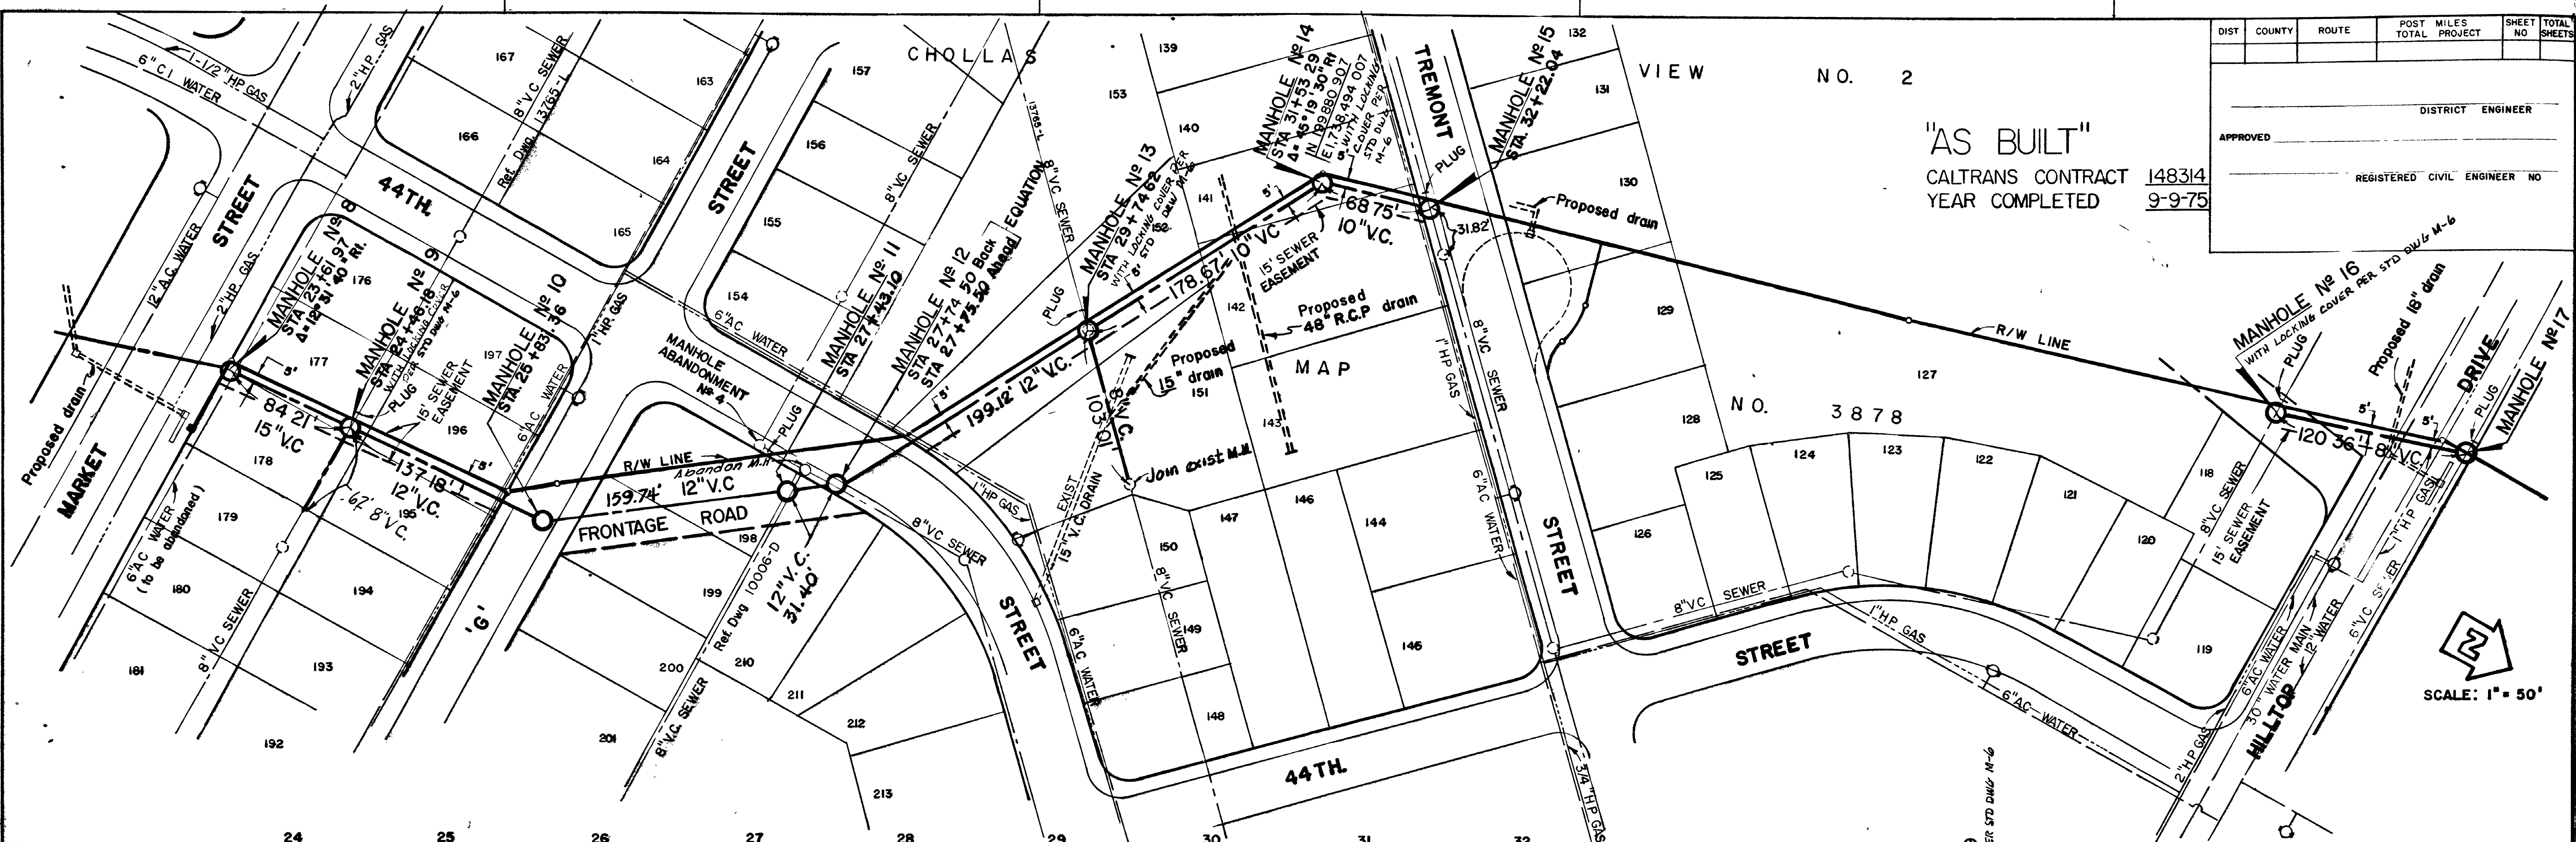