
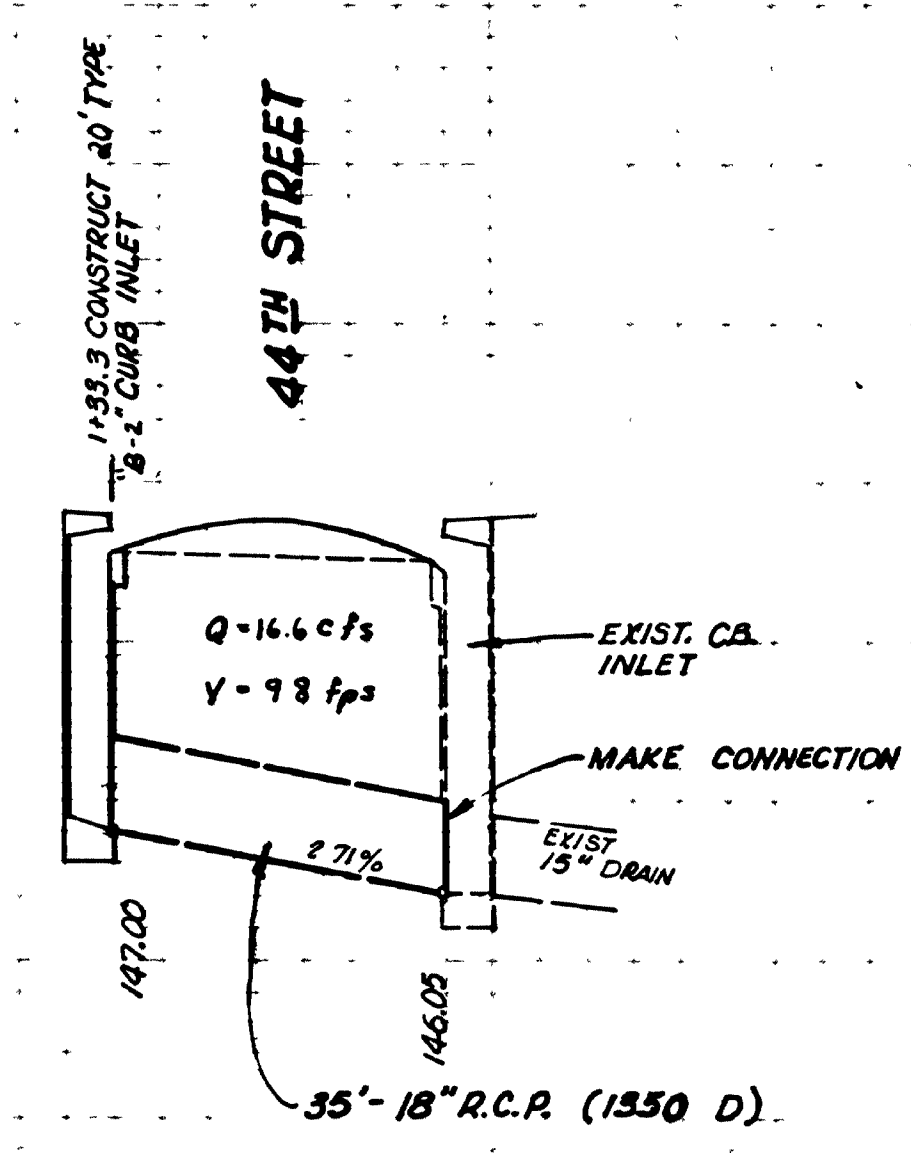


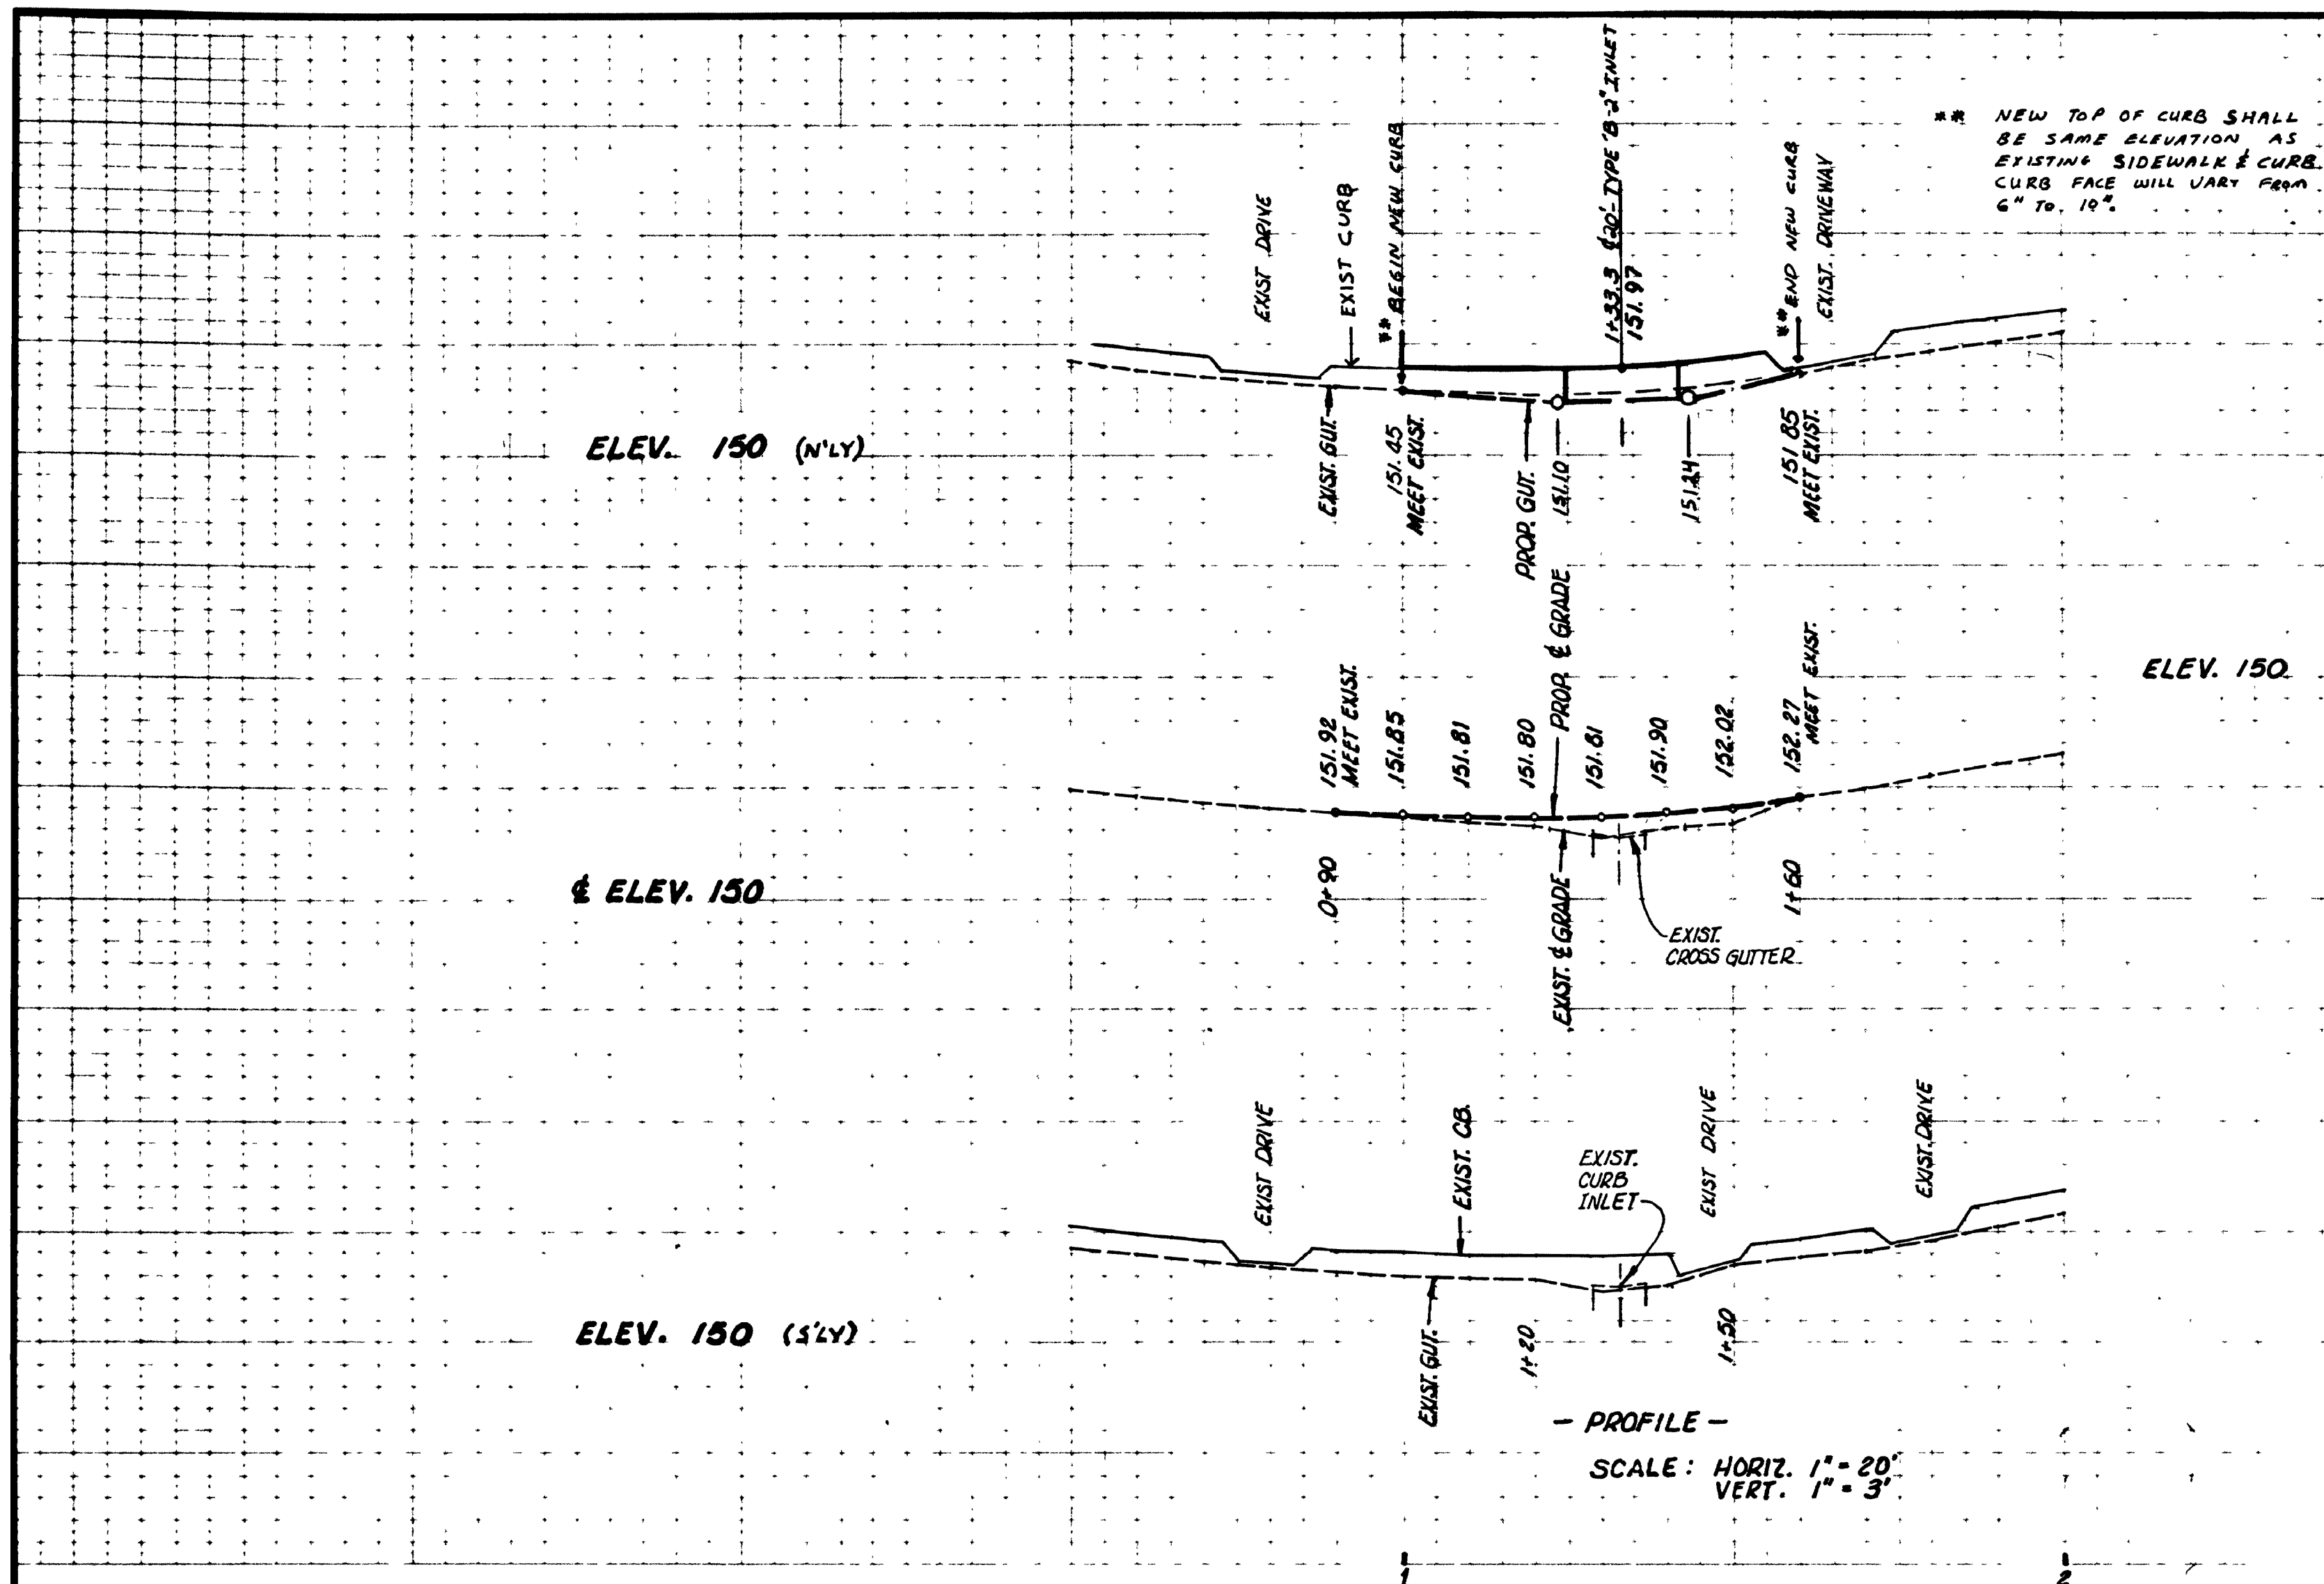

PROFILE - 18" R.C.P.
STA. 1+33.3
SCALE: HORIZ. 1" = 20'
VERT. 1" = 3'

MAINTAINING TRAFFIC FLOW- EXCEPT IN UNUSUAL SITUATIONS AS DEEMED APPROPRIATE BY THE CITY ENGINEER, THE CONTRACTOR SHALL MAINTAIN A MINIMUM OF ONE VEHICLE LANE IN EACH DIRECTION ON TWO-LANE STREETS AND A MINIMUM OF TWO LANES IN EACH DIRECTION FOR TRAFFIC ON ALL FOUR OR MORE LANE STREETS DURING THE WORKING HOURS OF 8:30 A.M. TO 3:30 P.M. FULL WIDTH ON ALL TRAVEL LANES ON EXISTING ROADWAYS MUST BE MAINTAINED DURING THE HOURS OF 3:30 P.M. TO 8:30 A.M. DAILY AND ON SATURDAYS, SUNDAYS AND DESIGNATED LEGAL HOLIDAYS, OR WHEN CONSTRUCTION OPERATIONS ARE NOT ACTIVELY IN PROGRESS ON WORKING DAYS. A FOUR-FOOT WIDE PEDESTRIAN ACCESS SHALL BE PROVIDED AND MAINTAINED IN ACCORDANCE WITH SECTION 7-101 OF THE STANDARD SPECIFICATIONS.

WORK TO BE DONE SCHEDULE

THE IMPROVEMENTS CONSIST OF THE FOLLOWING WORK TO BE DONE ACCORDING TO THESE PLANS AND THE FOLLOWING SPECIFICATIONS AND STANDARD DRAWINGS OF THE CITY OF SAN DIEGO.

STANDARD SPECIFICATION

STANDARD SPECIFICATIONS FOR PUBLIC WORKS CONSTRUCTION (1982 ED.), STANDARD SPECIAL PROVISIONS, AND CITY OF SAN DIEGO STANDARD SPECIAL PROVISIONS, DOCUMENT NO. 768688, FILED MAY 5, 1983.

STANDARD DRAWINGS

CITY OF SAN DIEGO STANDARD DRAWINGS, DOCUMENT NO. 768710, FILED JUNE 22, 1983.

IMPROVEMENTS	STD. DWGS	LEGEND
STORM DRAIN	SDG-103, D-60.1, D-61	
20' TYPE B-2 CURB INLET	D-21	
TYPE "G" CURB	G-2	
A.C. RESURFACING		
UNCLASSIFIED EXCAVATION		

REFERENCE DRAWINGS

LO 45068 (STATE RIGHT-OF-WAY); 5546-D (STREET IMPROVEMENT)

SURVEY REFERENCE

WENTWORTH 9-17-85 198-1737

BENCH MARK



N.W. BRASS PLUG 44TH STREET AND F STREET.
ELEV. 154.430 M.S.L.

PRIOR TO CONSTRUCTION THE CONTRACTOR SHALL CONTACT AND CO-OPERATE WITH THE OWNERS OF EXISTING IMPROVEMENTS WHICH MAY BE ENCOUNTERED OR AFFECTED IN ANY WAY UNDER THIS CONTRACT.

THE CONTRACTOR SHALL NOTIFY THE FOLLOWING AGENCIES 48 HOURS PRIOR TO STARTING WORK NEAR THEIR FACILITIES AND CO-OPERATE WITH THEM.

BUILDINGS & IRRIGATION	236-5500
UNDERGROUND SERVICE ALERT	1-800-422-4139
COMMUNICATIONS DIVISION	236-5505
CITY WATER & SEWER	236-5650

STREET CLASSIFICATION: 44TH STREET - LOCAL STREET

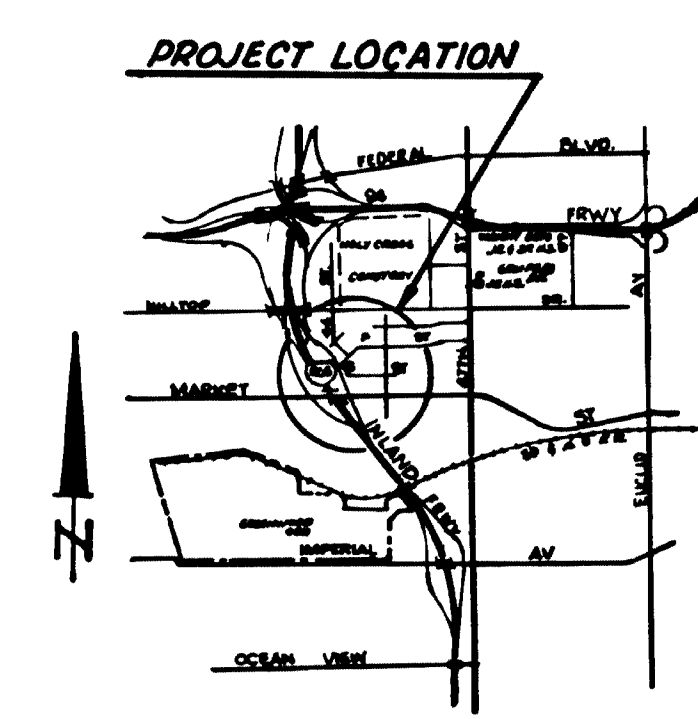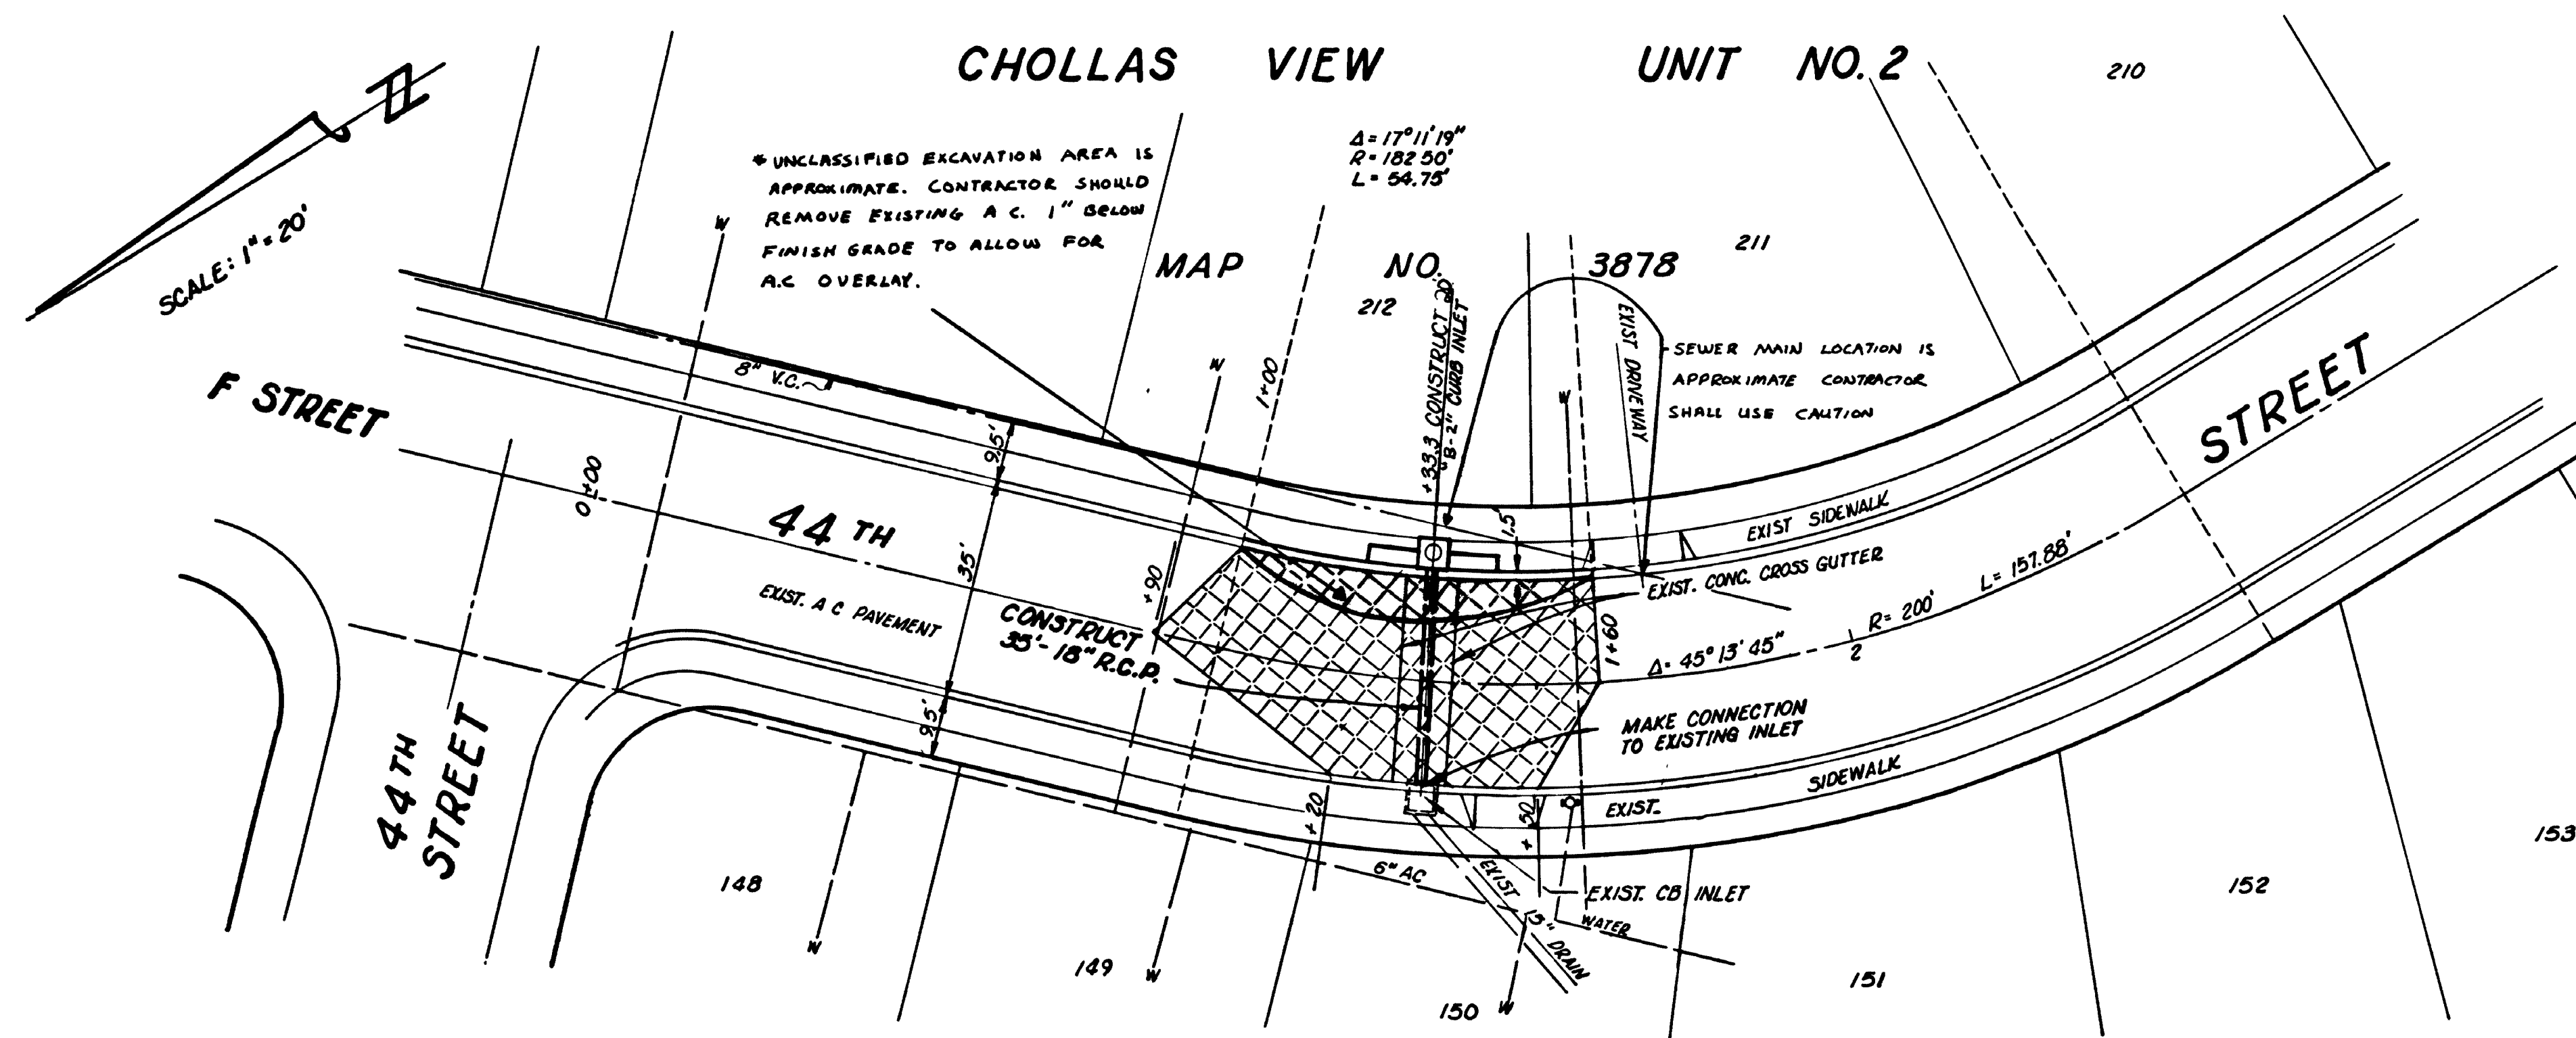

LOCATION MAP
NO SCALE

CIP 11-218.0

SPECIFICATION NO. 5436

THE CONSTRUCTION OF 44TH STREET STORM DRAIN

CITY OF SAN DIEGO, CALIFORNIA ENGINEERING AND DEVELOPMENT DEPARTMENT SHEET 1 OF 1 SHEETS				W.O. NO. 118722
DESIGNER	BY	APPROVED	DATE	FILED
ORIGINAL	ARD	ARC	1-1986	
AS BUILT	J.R.			
CONTRACTOR: A.R. CONST.	DATE STARTED: 7-18-86	198-1737		
INSPECTOR: K. ESTRADA	DATE COMPLETED: 8-27-86	22308-1-D		

AS BUILT