
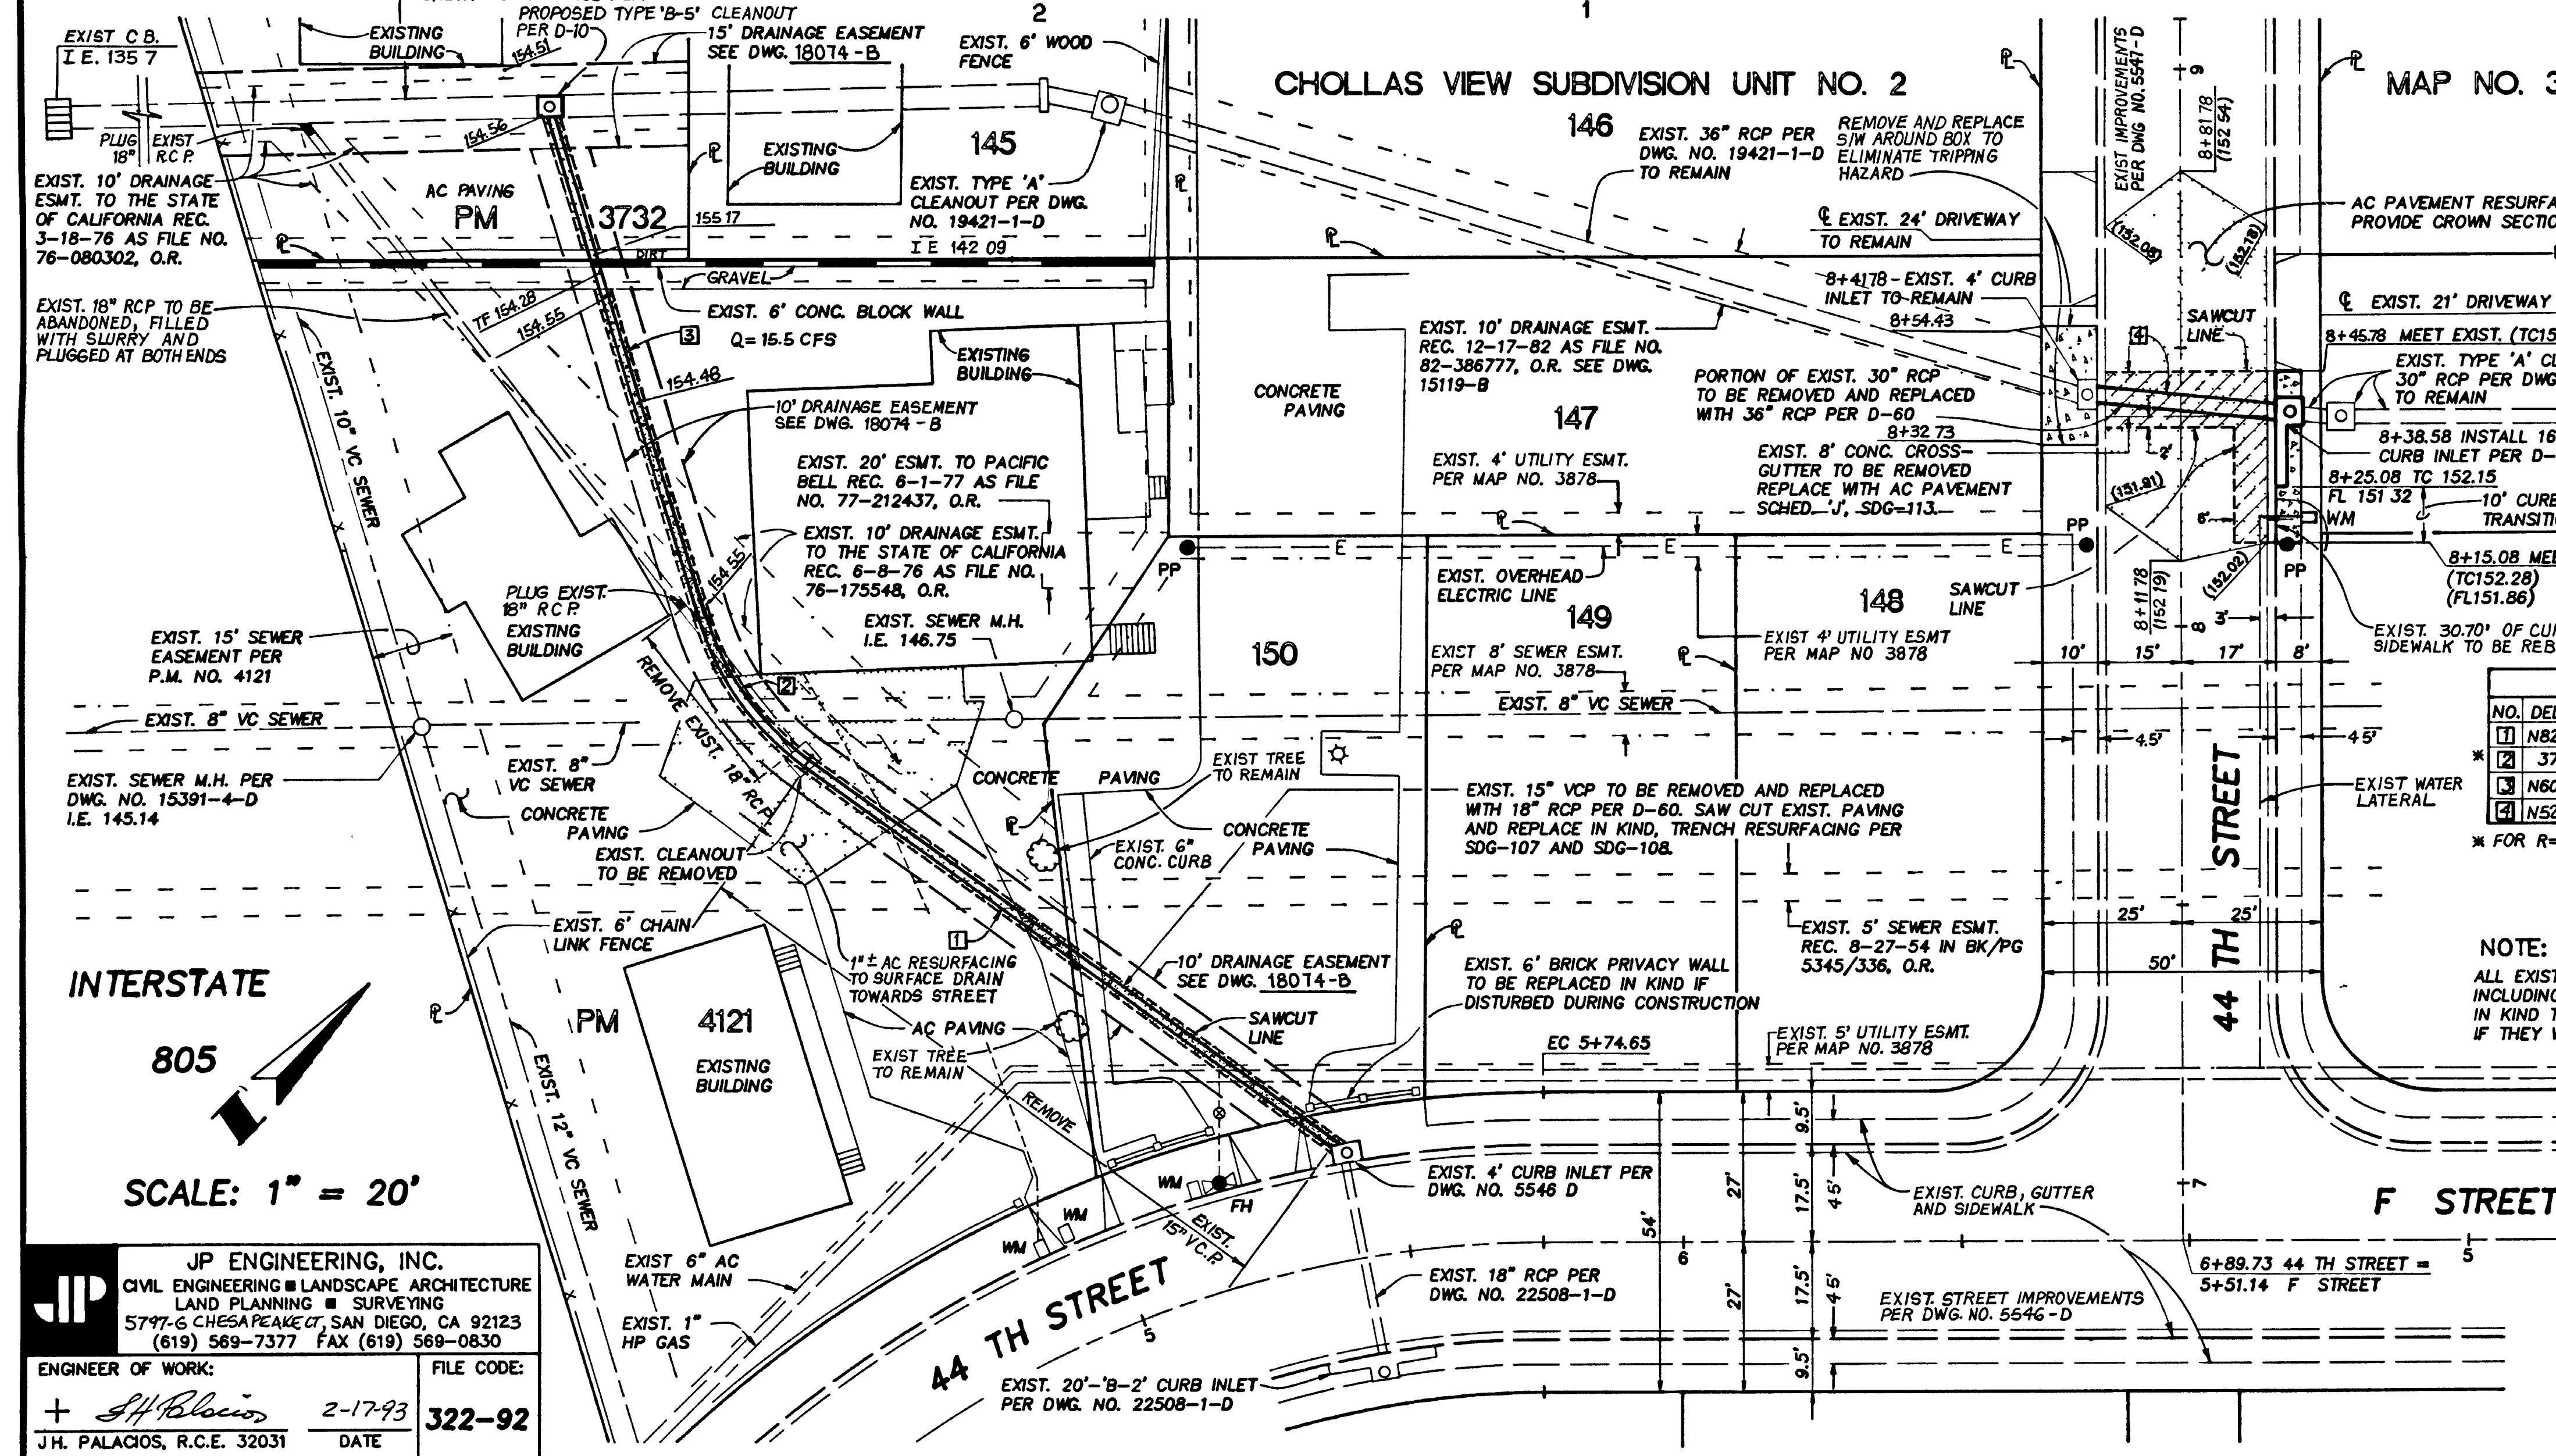
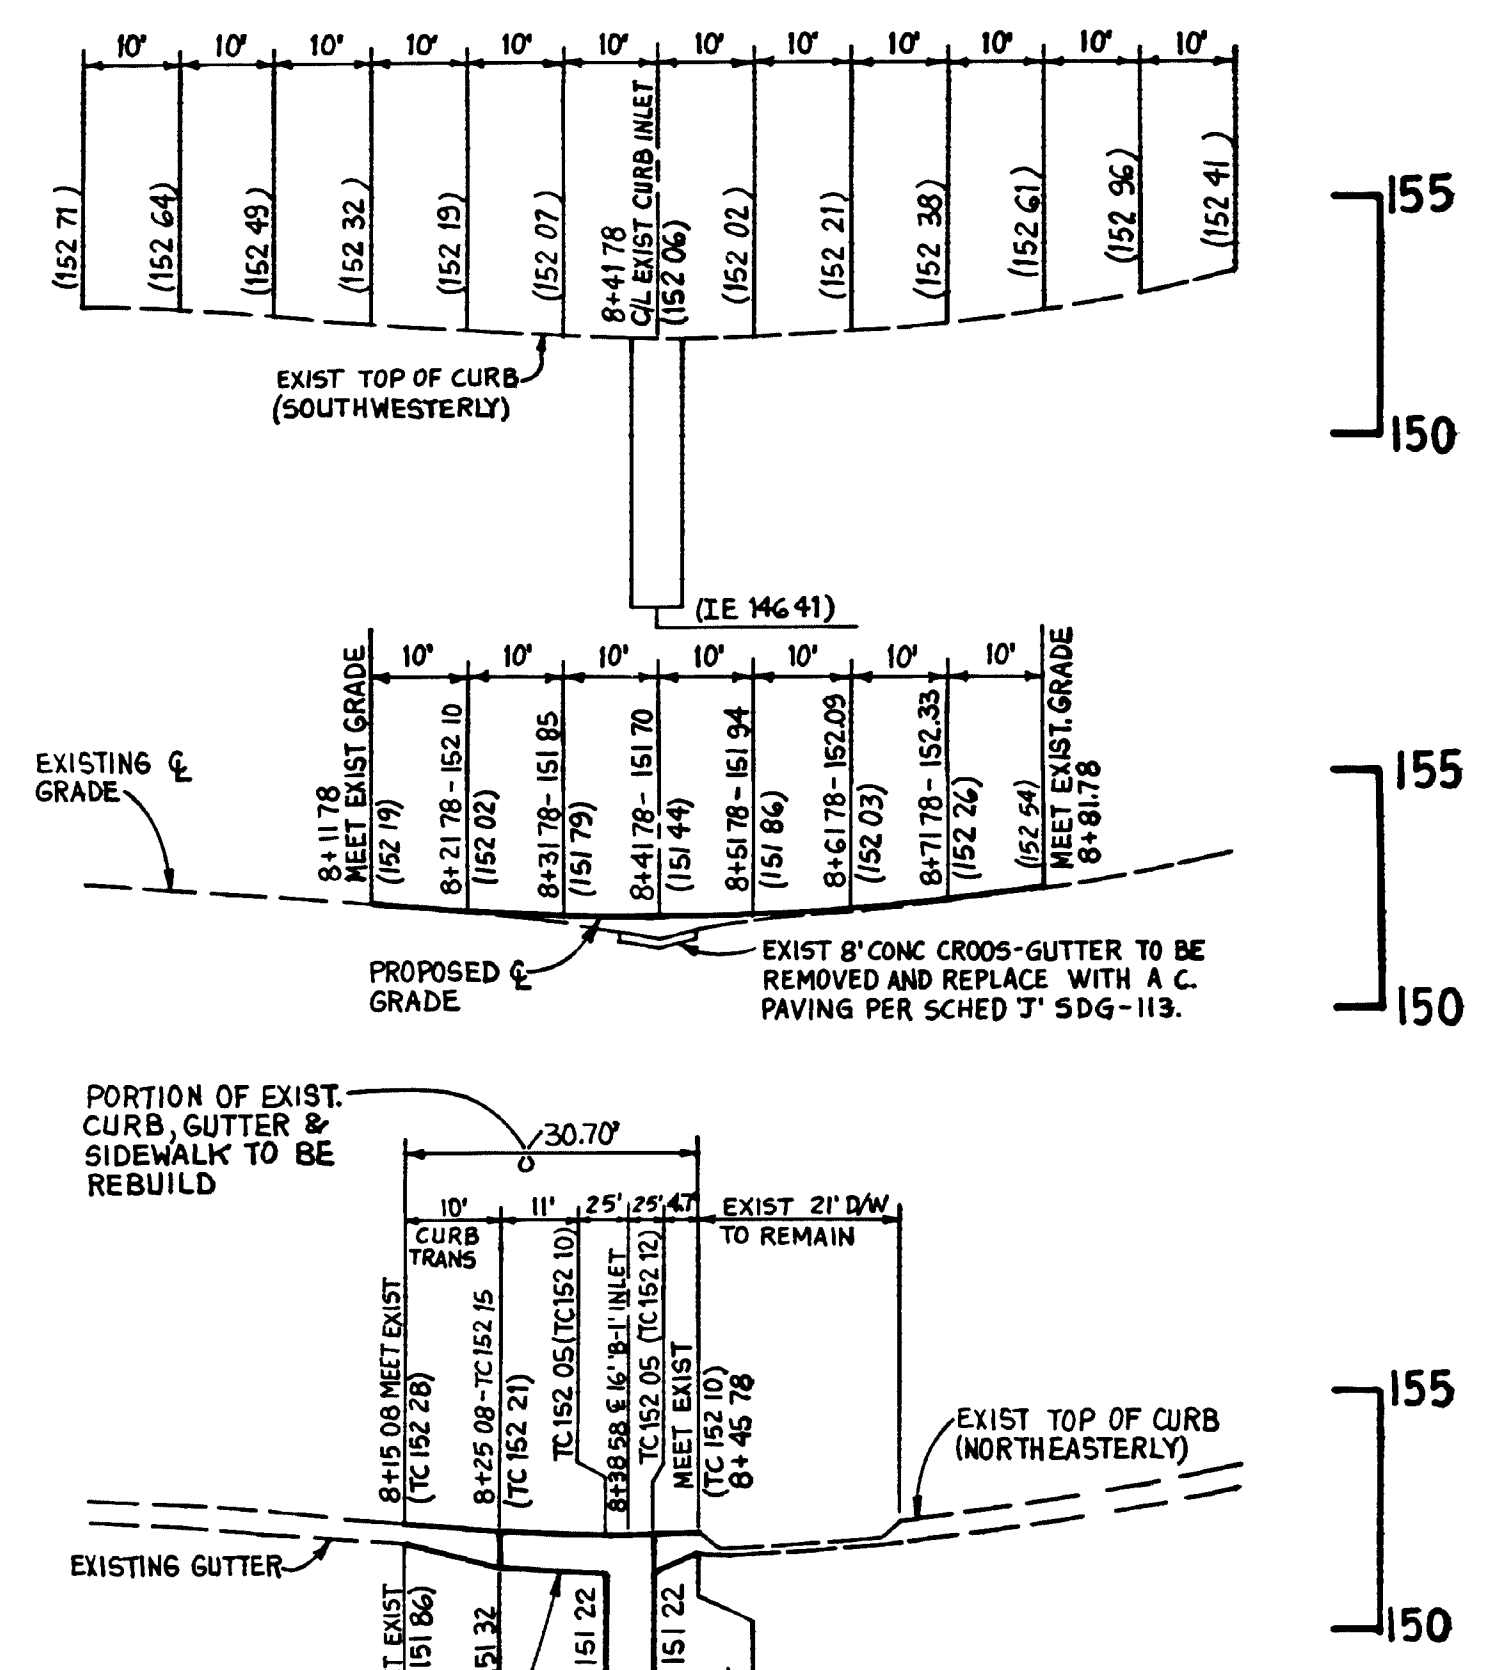
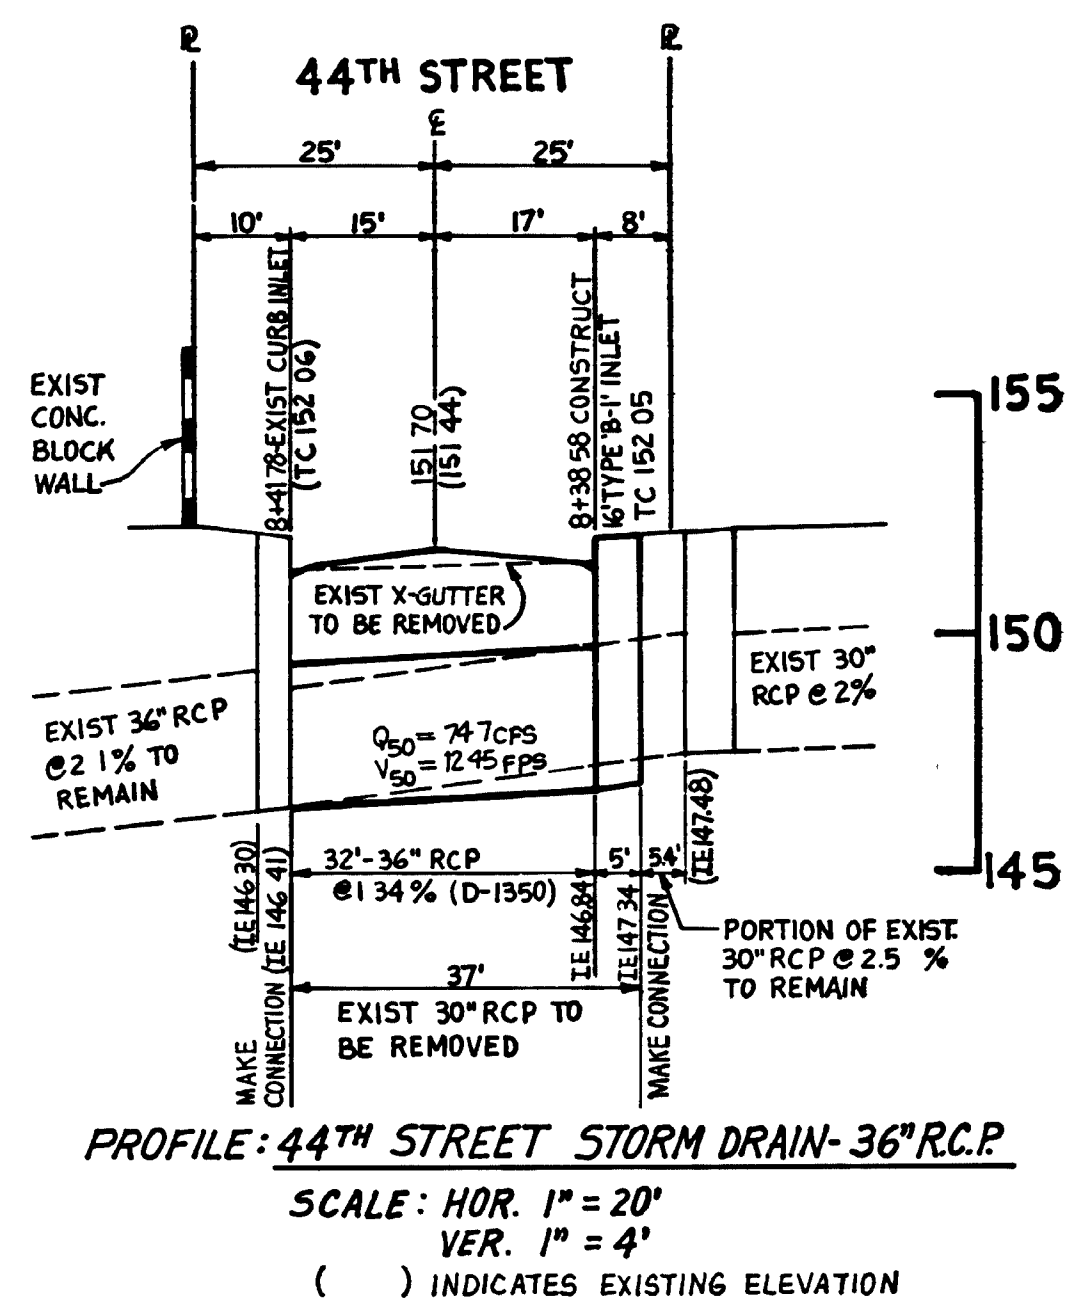


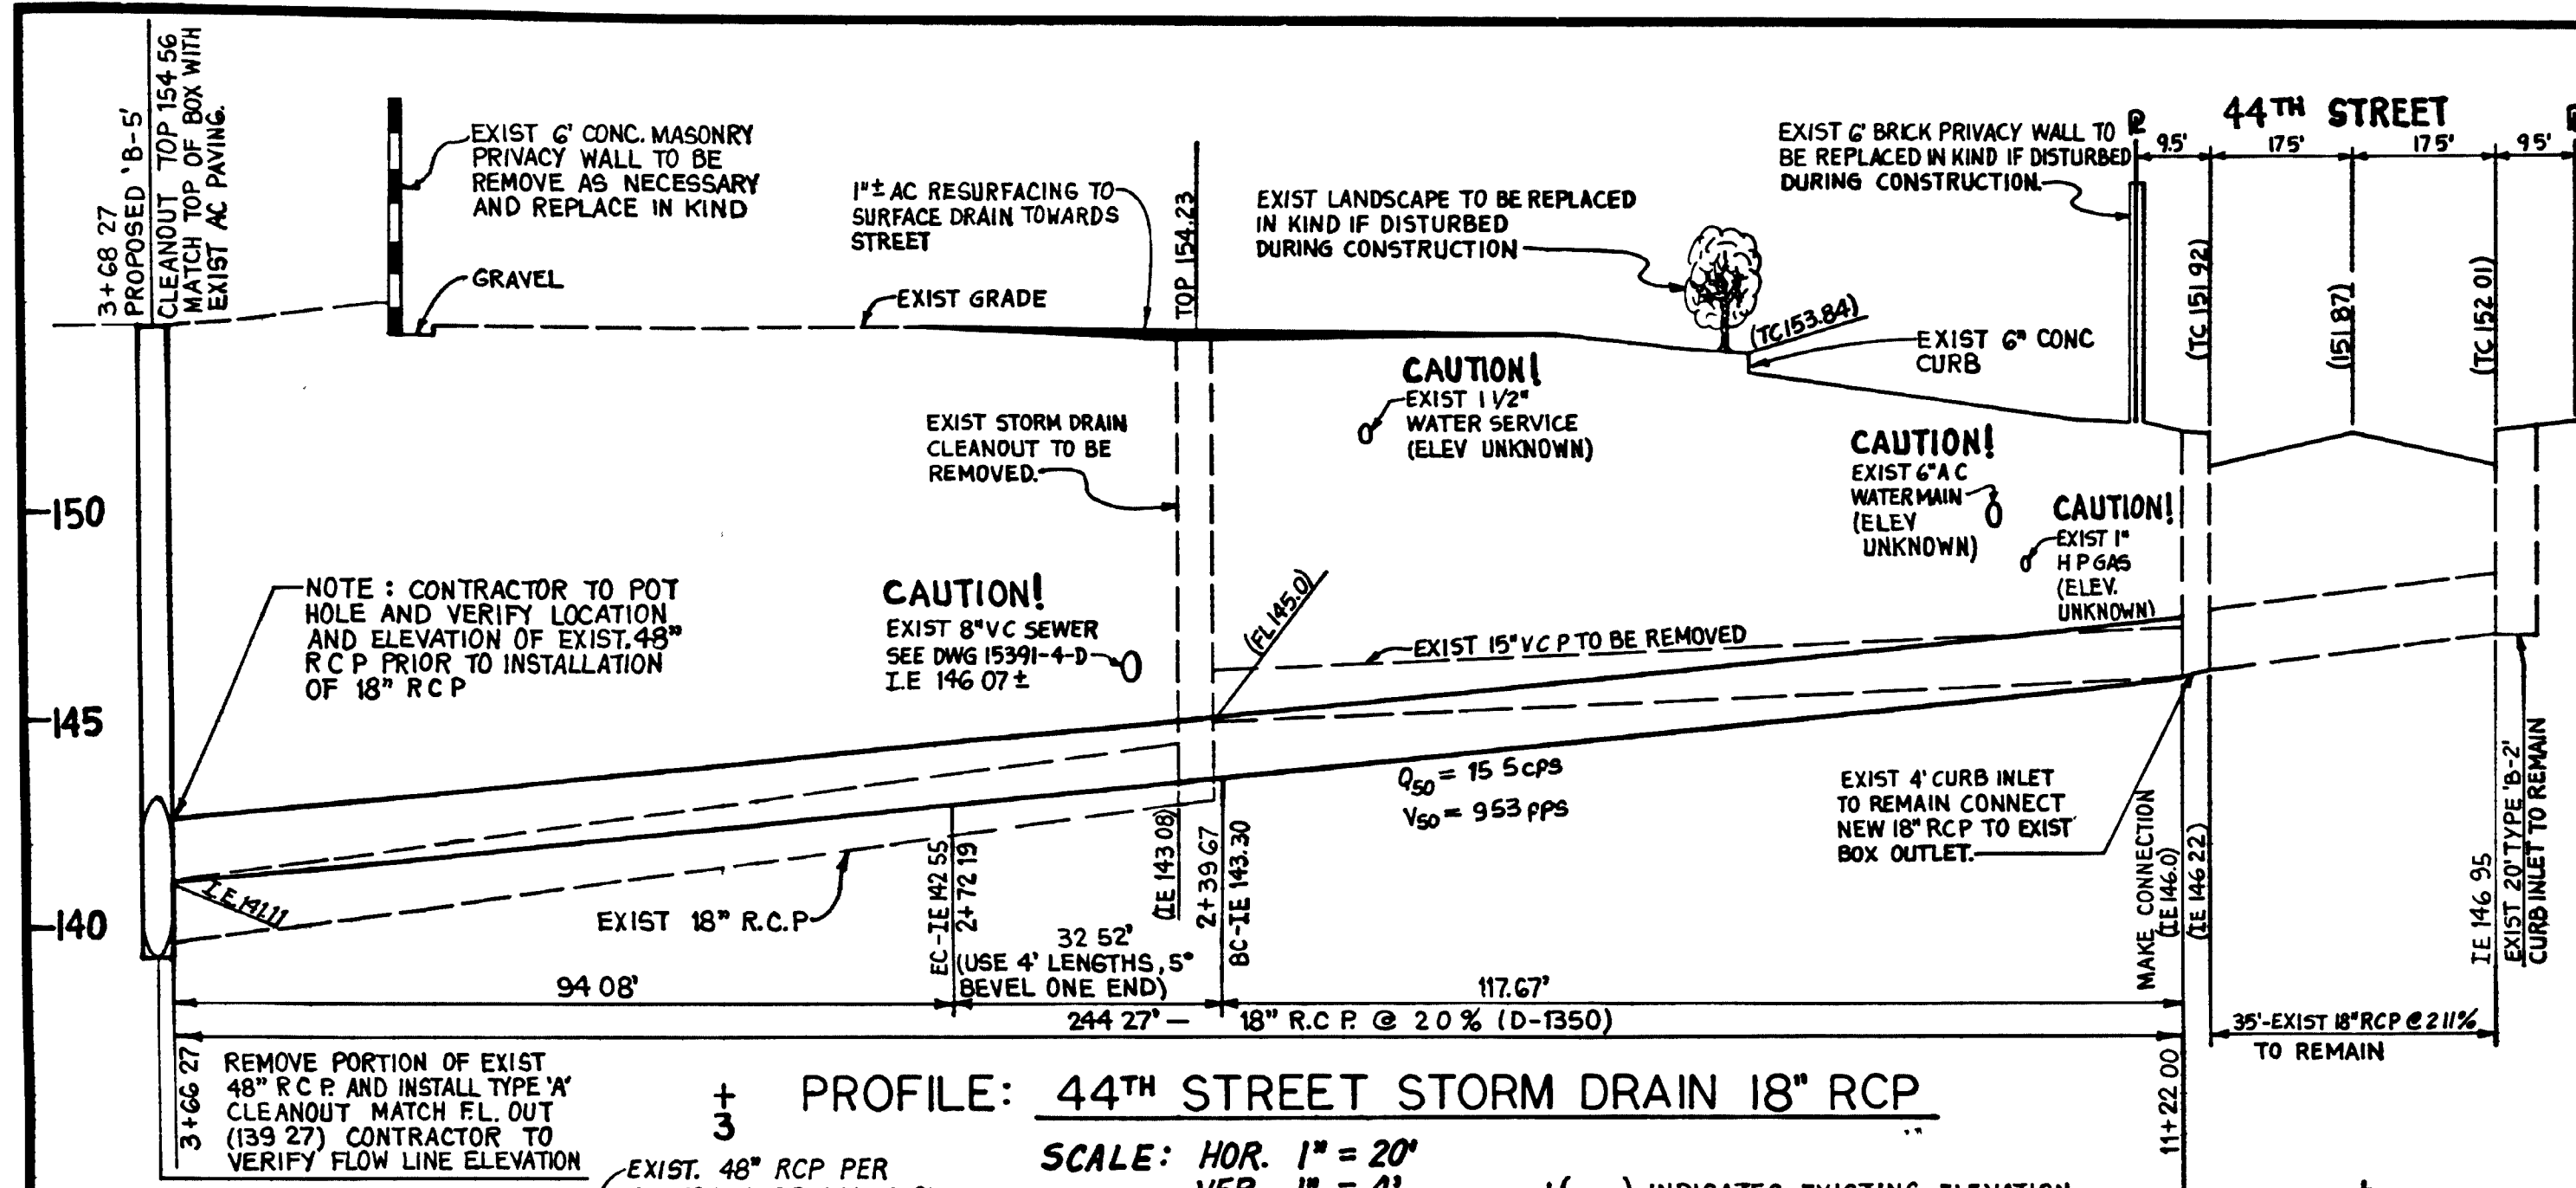

STORM DRAIN DATA

NO.	DELTA/BRG.	RADIUS	LENGTH	REMARKS
1	N82°37'11"E	---	117.67'	18" RCP (D-1350)
2	37°15'57"	50.00'	32.52'	"
3	N60°06'52"W	---	94.08'	"
4	N52°07'32"E	---	32.15'	36" RCP (D-1350)

* FOR R=50' USE 4' LENGTHS, 5' BEVEL ONE END

NOTE:
ALL EXISTING PUBLIC AND PRIVATE IMPROVEMENTS, INCLUDING TREES AND LANDSCAPE, SHALL BE REPLACED IN KIND TO THE SATISFACTION OF THE CITY'S INSPECTOR, IF THEY WERE DISTURBED DURING THE CONSTRUCTION PROCESS.

SPECIFICATION NO. 6369

PUBLIC IMPROVEMENTS FOR:
STORM DRAIN IN 44 TH STREET

CITY OF SAN DIEGO, CALIFORNIA
ENGINEERING DEPARTMENT
SHEET 2 OF 2 SHEETS

W.O. NO. 112103

FOR CITY ENGINEER: *[Signature]* DATE: 4/1/99

DESIGNER: *[Signature]*

CONTROL CERTIFICATION: 198-1737

CONTRACTOR: SCV CONTRACTING DATE STARTED: 9-18-94 DATE COMPLETED: 10-26-94

INSPECTOR: ABL PALACIOS

26933-2-D

AS-BUILT

JP ENGINEERING, INC.
CIVIL ENGINEERING ■ LANDSCAPE ARCHITECTURE
LAND PLANNING ■ SURVEYING
5797-G CHESAPEAKE CT, SAN DIEGO, CA 92123
(619) 569-7377 FAX (619) 569-0830

ENGINEER OF WORK: *[Signature]* 2-17-93
J.H. PALACIOS, R.C.E. 32031

FILE CODE: 322-92

