


INDEX OF SHEETS

Sheet No.	Title	Br. No.
1	Title Sheet	
2-4	Typical Cross Sections	
5	Standard Plans List	
6-13	Layout Plans	
14	Market Street Detour	
15-28	City Street Plans	
29-47	Profiles	
48-49	Embankment (805/54 Area)	
50	Miscellaneous Details	
51-59	Contour Grading and Drainage Plans	
60-73	Drainage Profiles	
74-80	Drainage Details	
81-86	Drainage List	
87-99	Sewer and Water Plans	
100-105	Utility Plans	
106-107	Quantities	
108-110	Special Details	
111-127	Traffic Plans	
128-154	Signs, Lighting and Overhead Sign Plans	


BRIDGE PLANS

155-168	Greenwood U.P.	Br. No. 57-840
169-179	47th Street U.P.	Br. No. 57C-321
180-196	Market Street O.C.	Br. No. 57-858
197-208	Market Street Off-Ramp O.C.	Br. No. 57-842
209-220	Market Street On-Ramp O.C.	Br. No. 57-841
221-236	Hilltop Drive O.C.	Br. No. 57-660
237	Federal Boulevard U.C.	Br. No. 57-668

1-270 Cross-sections

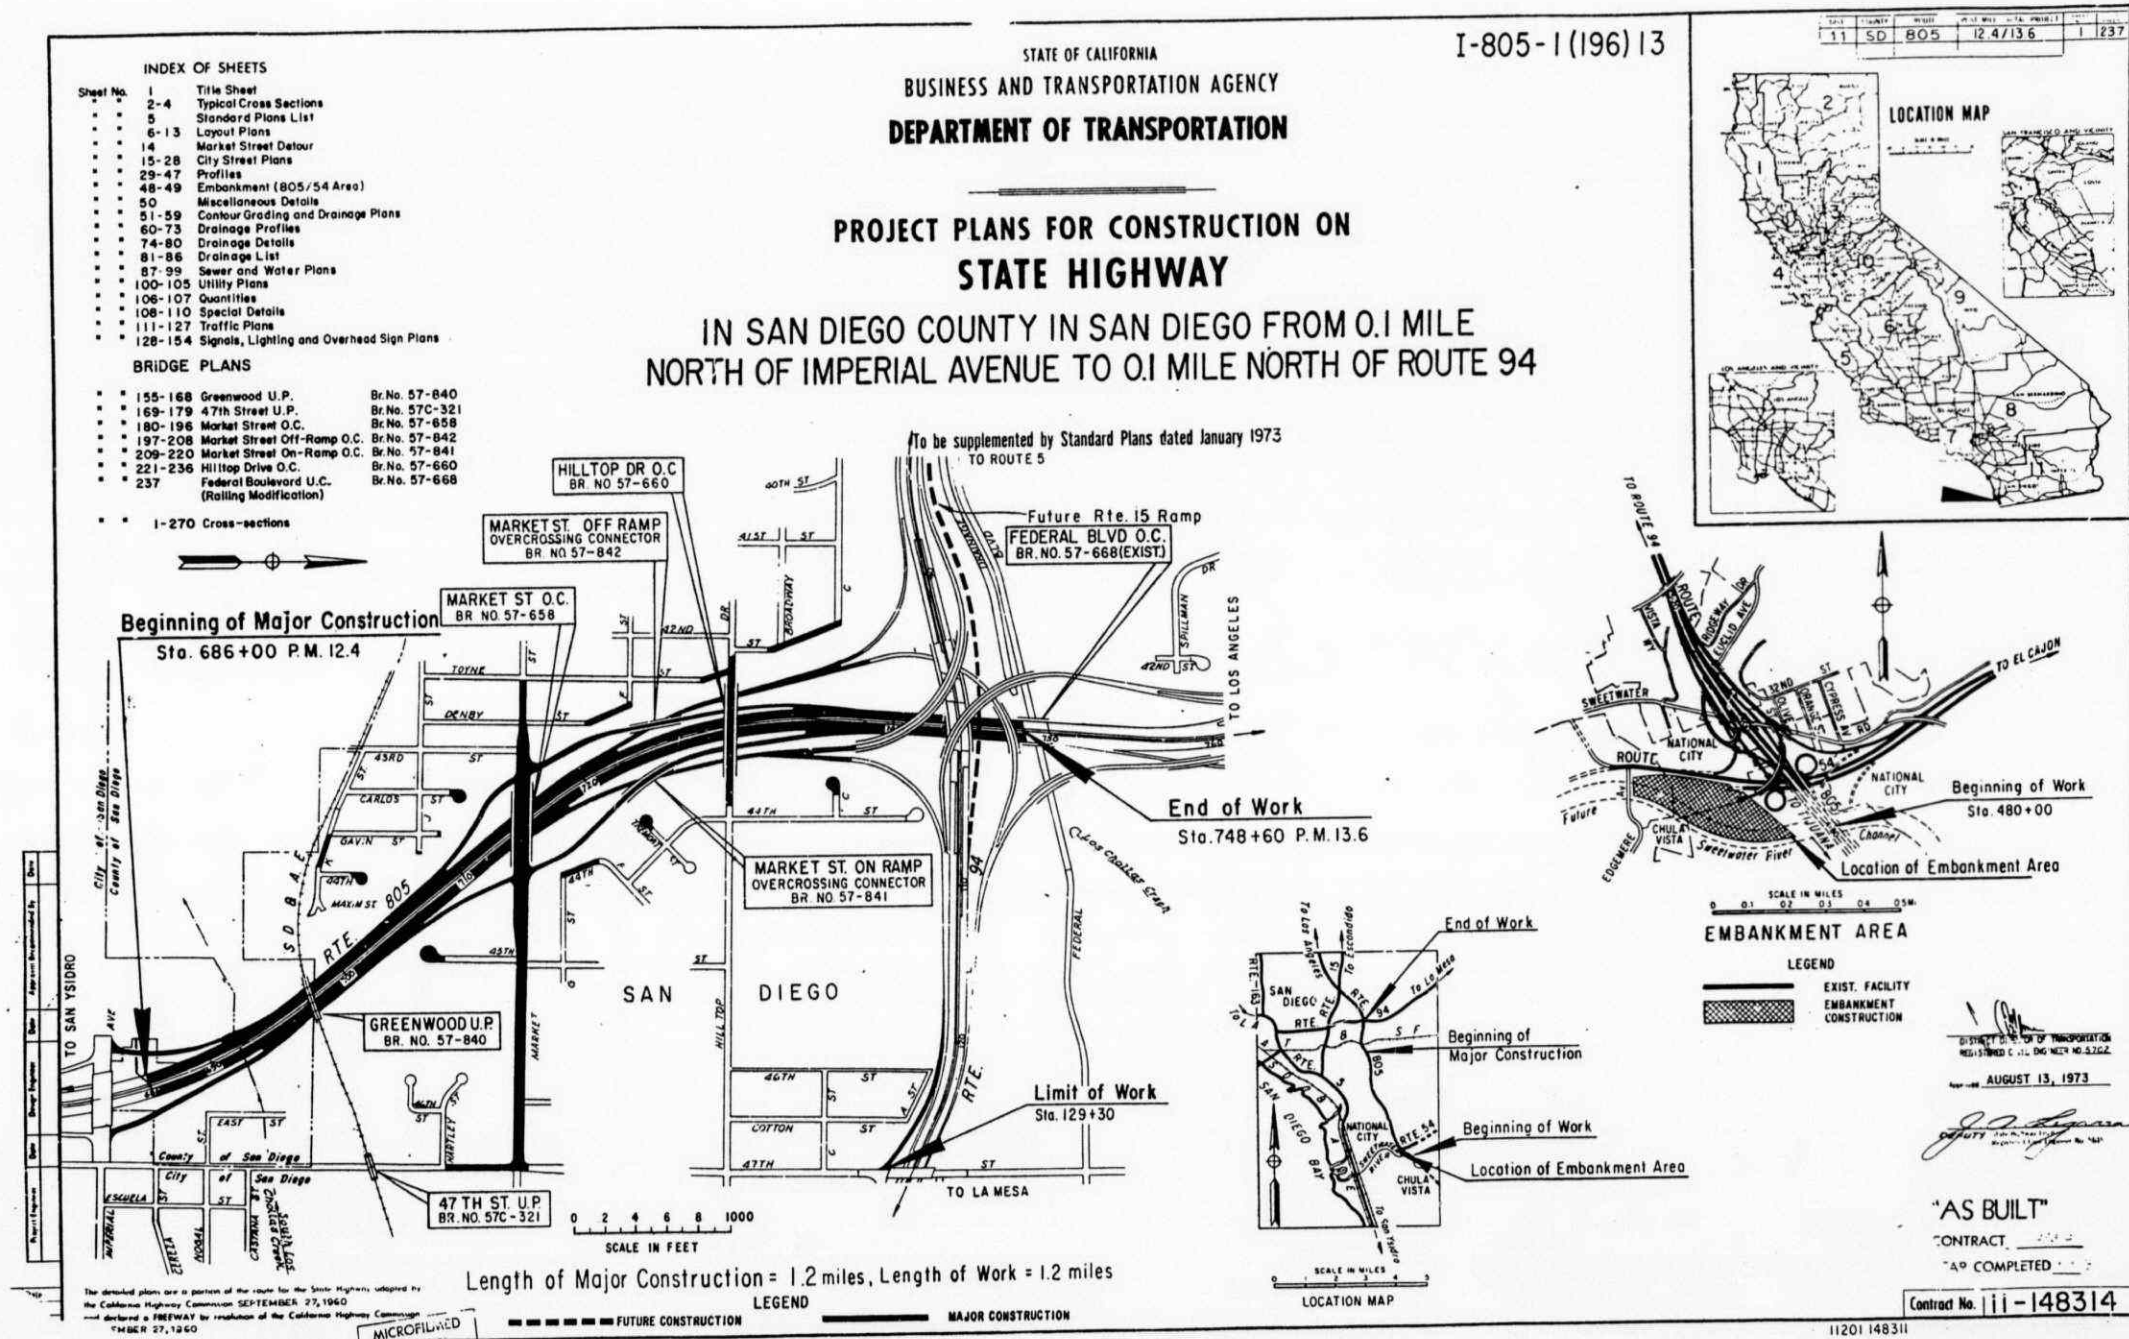

AS BUILT PLANS
 Contract No. 11-148314
 Date Completed 5/1/74
 Document No. 11-148314

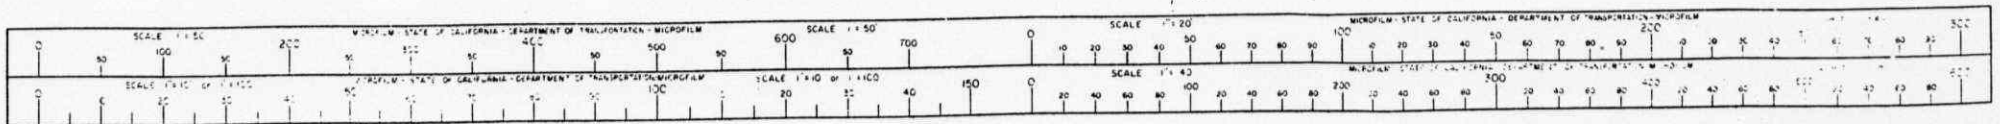

31137-1-D
 FILMED 5-22-1