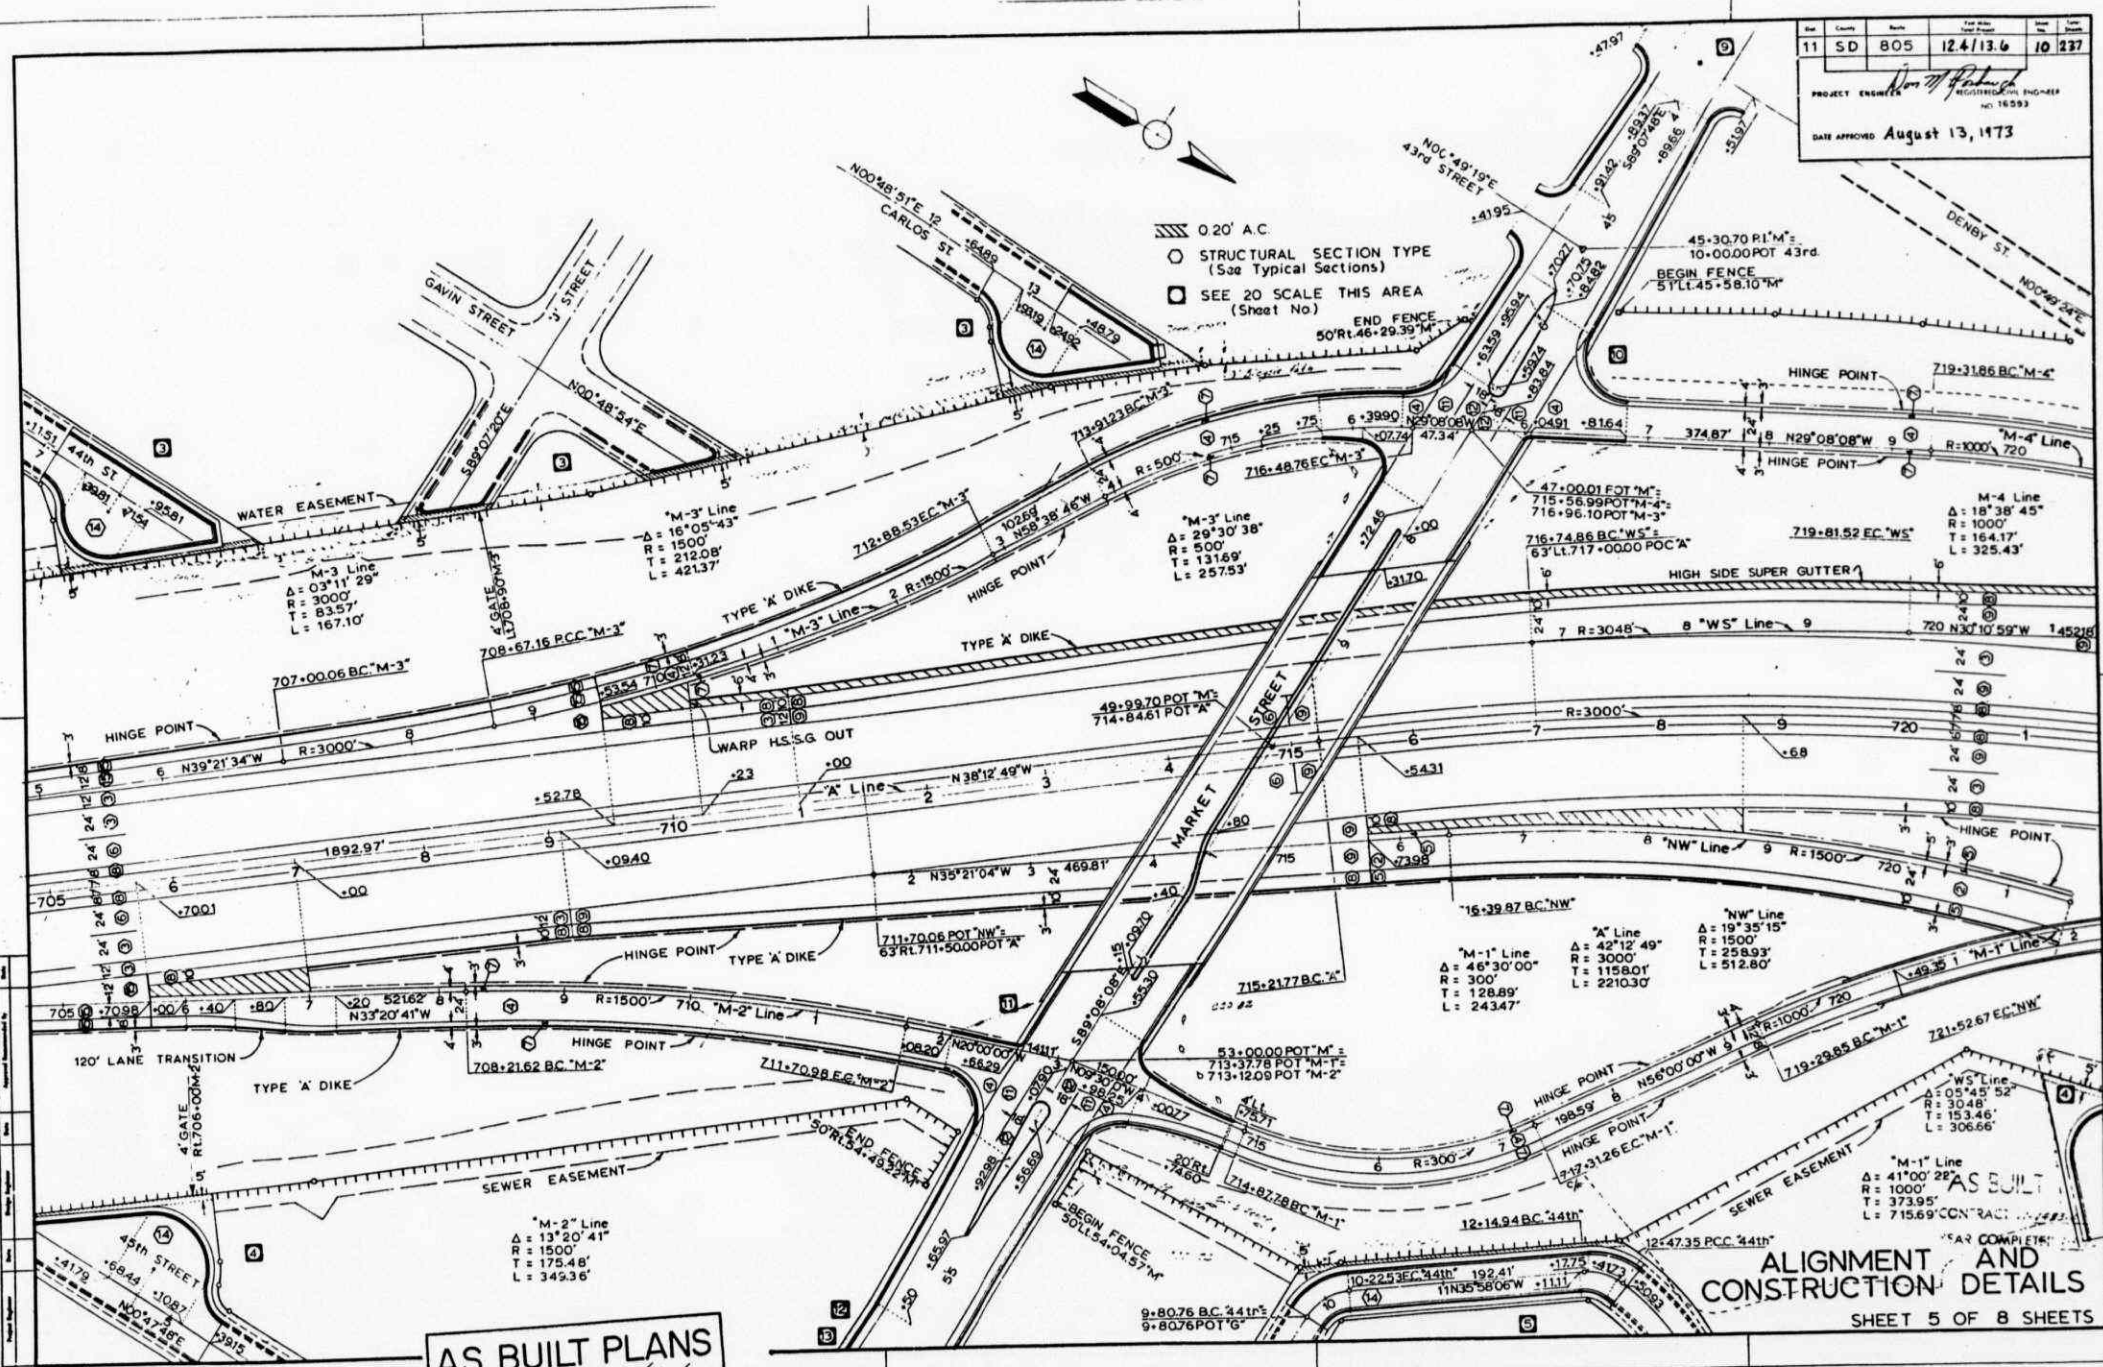


3 OF 6

31137-3-D
FILMED 5-22-1