


BLOCK 8
SUNSET TRACT MAP NO 564

MARKET

STREET

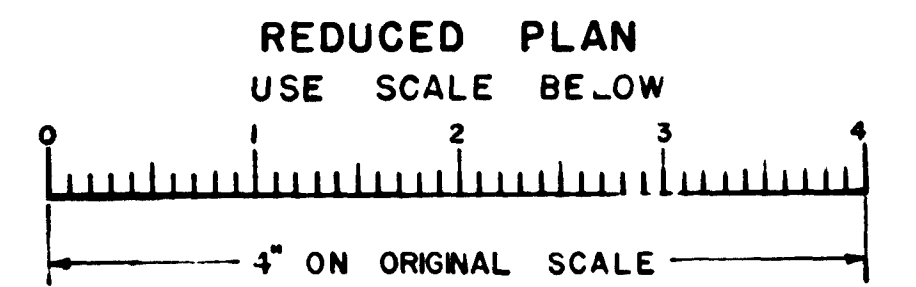

SHEET 2 CITY OF SAN DIEGO 16 SHEETS

PLANS FOR THE CONSTRUCTION OF
IMPROVEMENTS IN
**ACQUISITION AND IMPROVEMENT
DISTRICT NO 3**

De Roebuck
CITY OF SAN DIEGO
COUNTY OF SAN DIEGO, CALIFORNIA

CITY DATUM
ADD 611.9 FEET
TO CONVERT TO
MEAN SEA LEVEL

5. 44th. Floor. 45th. Market
MAXIM

4688-L

PORTION LOT 38

EX MISSION LANDS
MAP NO 283

Scale 1 inch = 50 feet

