
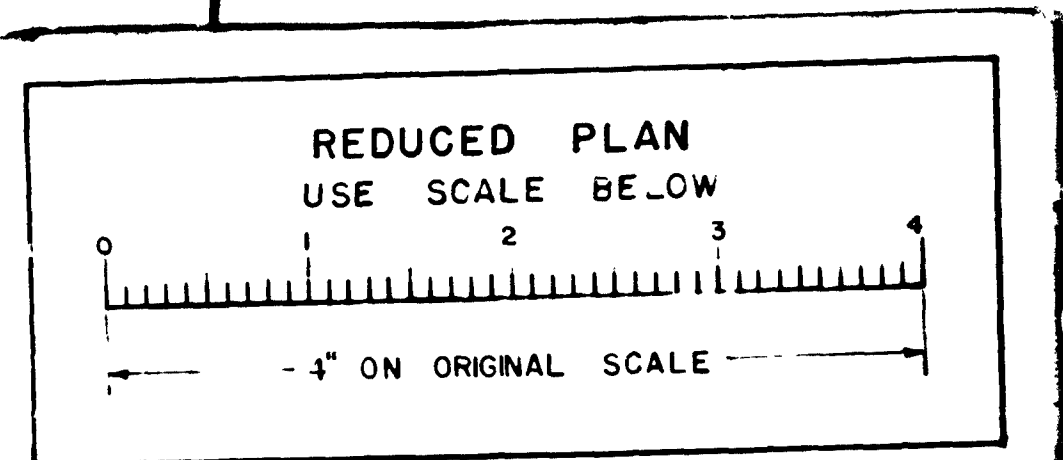


PORTION LOT 33
EX MISSION LANDS MAP NO 283

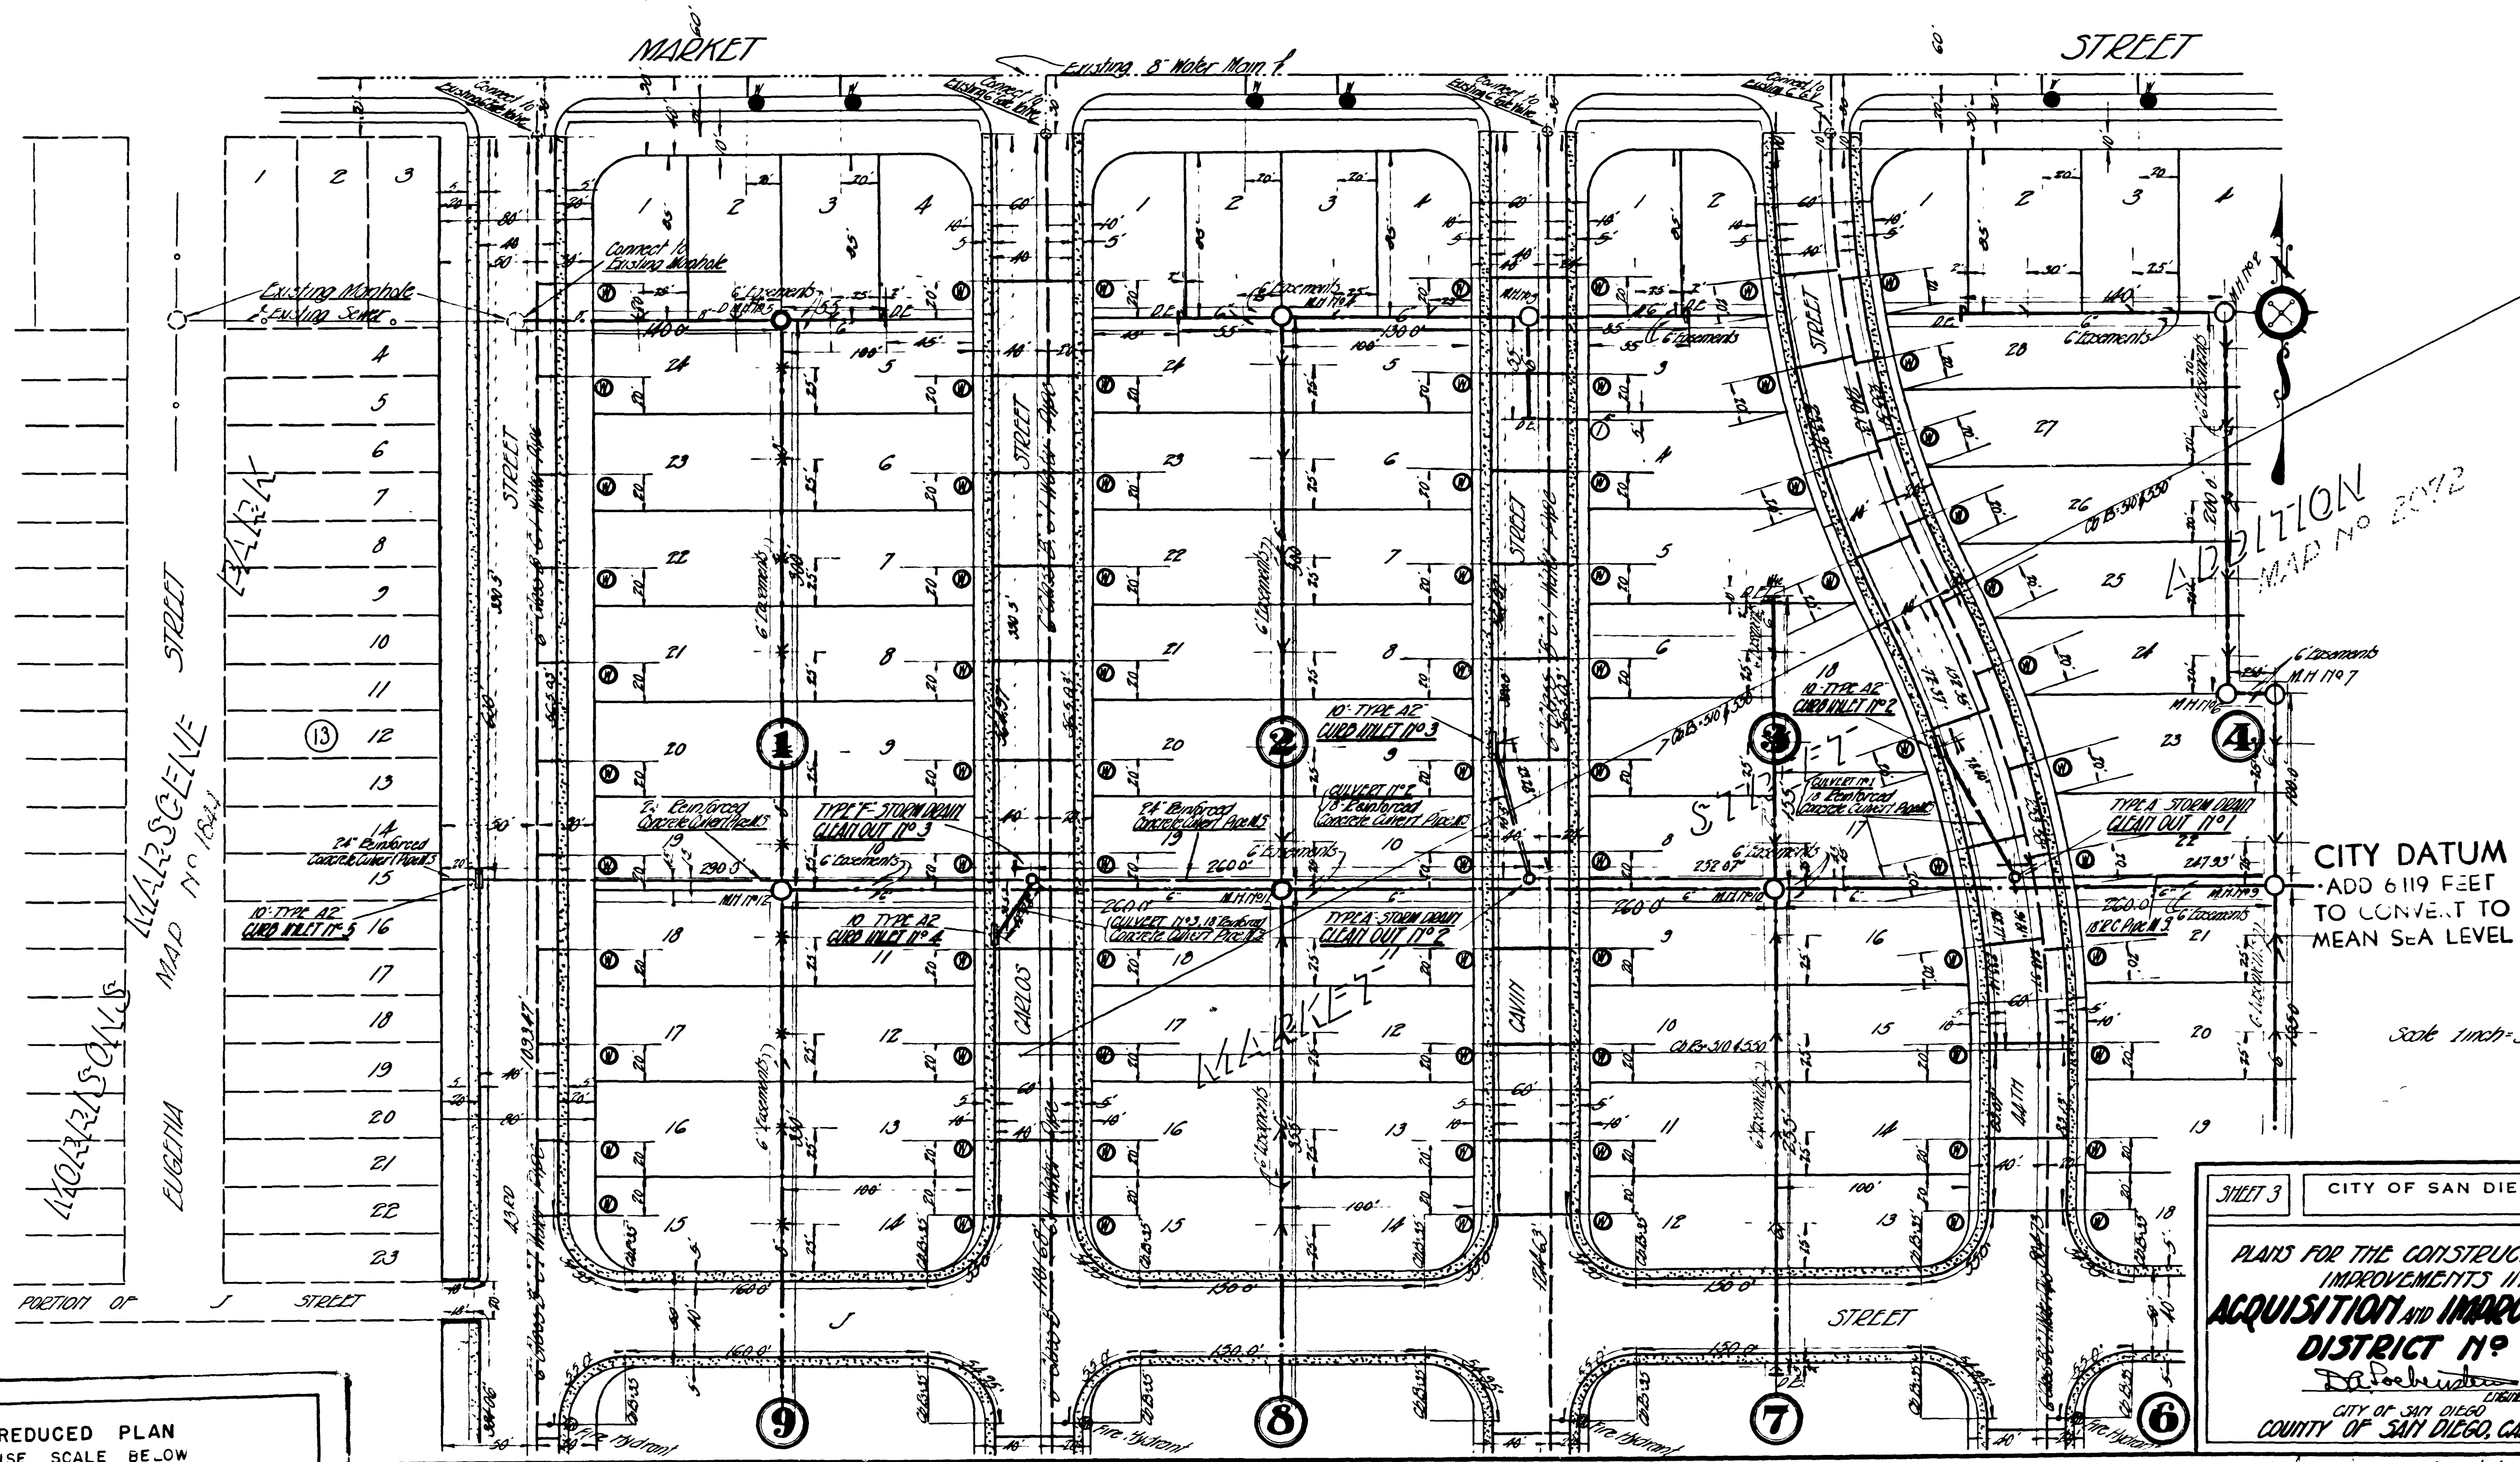

SHEET 3 CITY OF SAN DIEGO 16 SHEETS

PLANS FOR THE CONSTRUCTION OF IMPROVEMENTS IN ACQUISITION AND IMPROVEMENT DISTRICT NO 3

City of San Diego
COUNTY OF SAN DIEGO, CALIFORNIA

43rd, Carlos Cassin, 44th, J St, Market

4689-L

Cost