

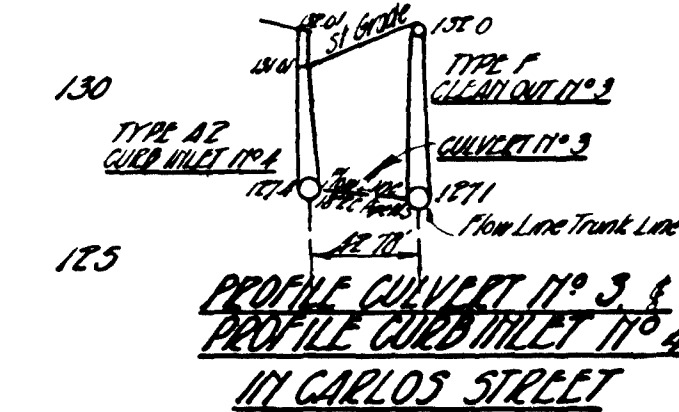
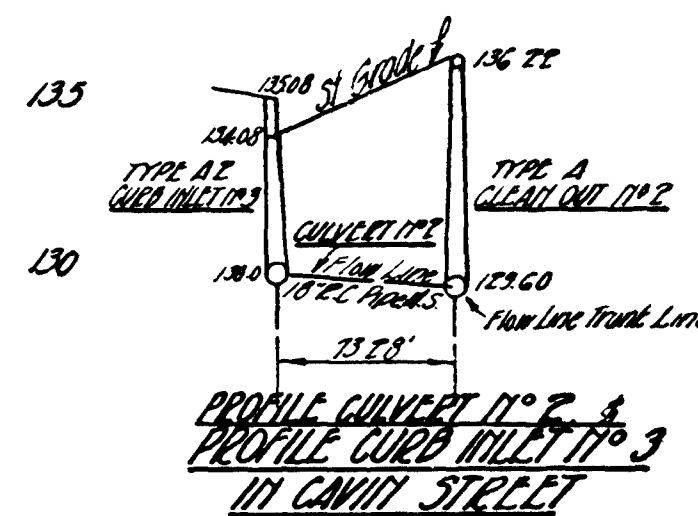
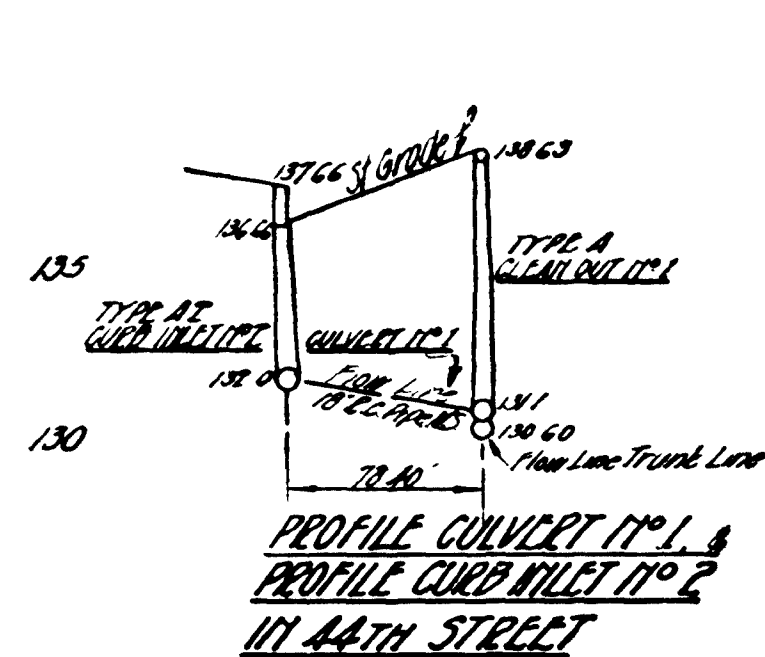


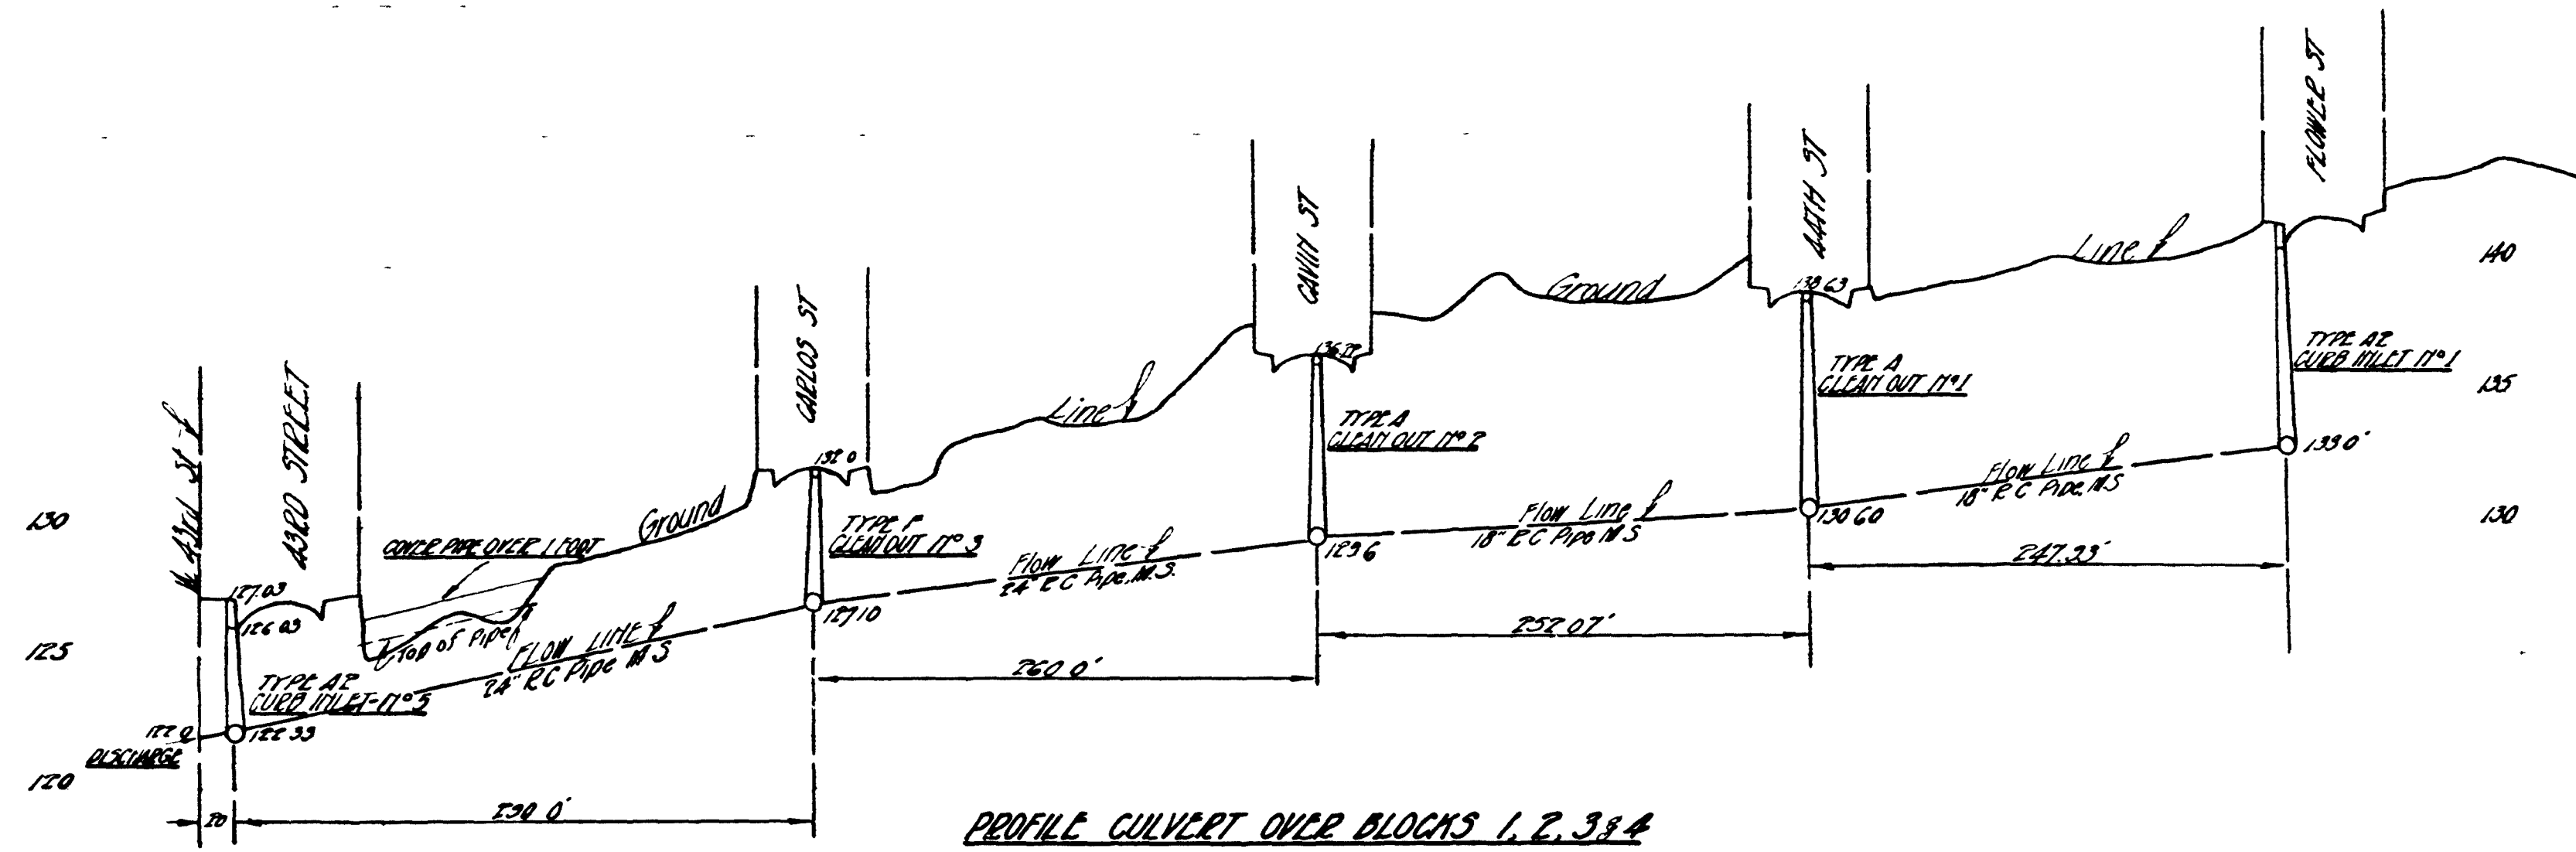

CURB INLETS ARE ALL
 10" TYPE A2 CURB INLETS
 CLEAN OUT BOXES ARE ALL
 TYPE A STANDARD STORM DRAIN CLEAN OUTS
 EXCEPT THAT IN CARLOS STREET WHICH IS
 TYPE F STANDARD STORM DRAIN CLEAN OUT
 CULVERT PIPE IS
 Reinforced Concrete Pipe, Medium Steel

CITY DATUM
 ADD 6.119 FEET
 TO CONVERT TO
 MEAN SEA LEVEL

Scale: Horizontal, 1"=30'
 Vertical, 1"=6'

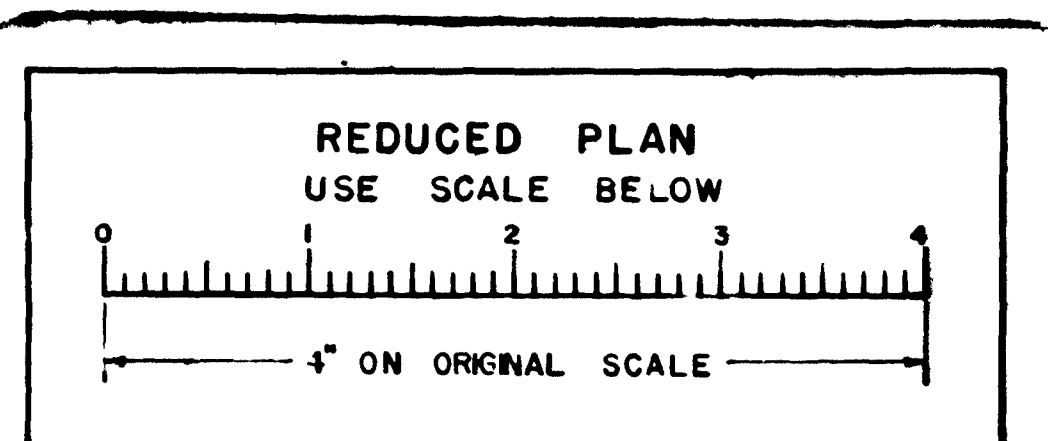

Profile

MICROFILMED
APR - - 1963

SHEET 7	CITY OF SAN DIEGO	16 SHEETS
---------	-------------------	-----------

PLANS FOR THE CONSTRUCTION OF
 IMPROVEMENTS IN
ACQUISITION AND IMPROVEMENT
DISTRICT NO 3
 [Signature]
 CITY OF SAN DIEGO
 SAN DIEGO COUNTY, CALIFORNIA

Culverts

4701-1