
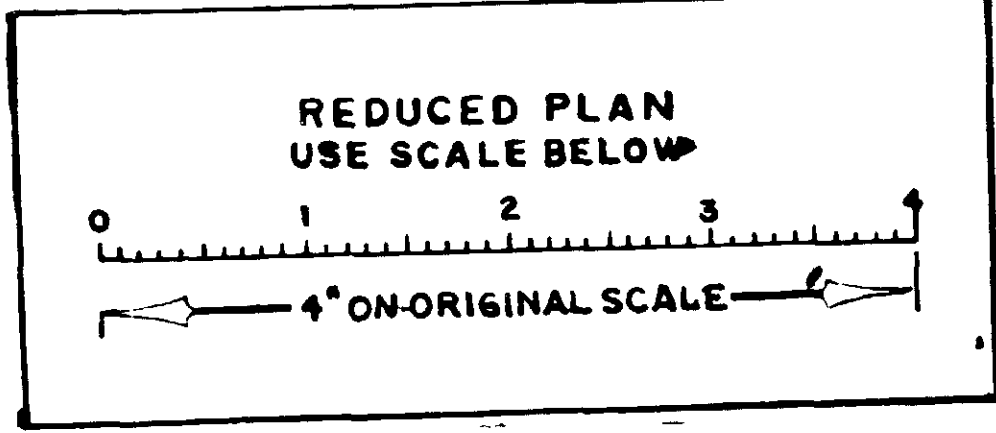


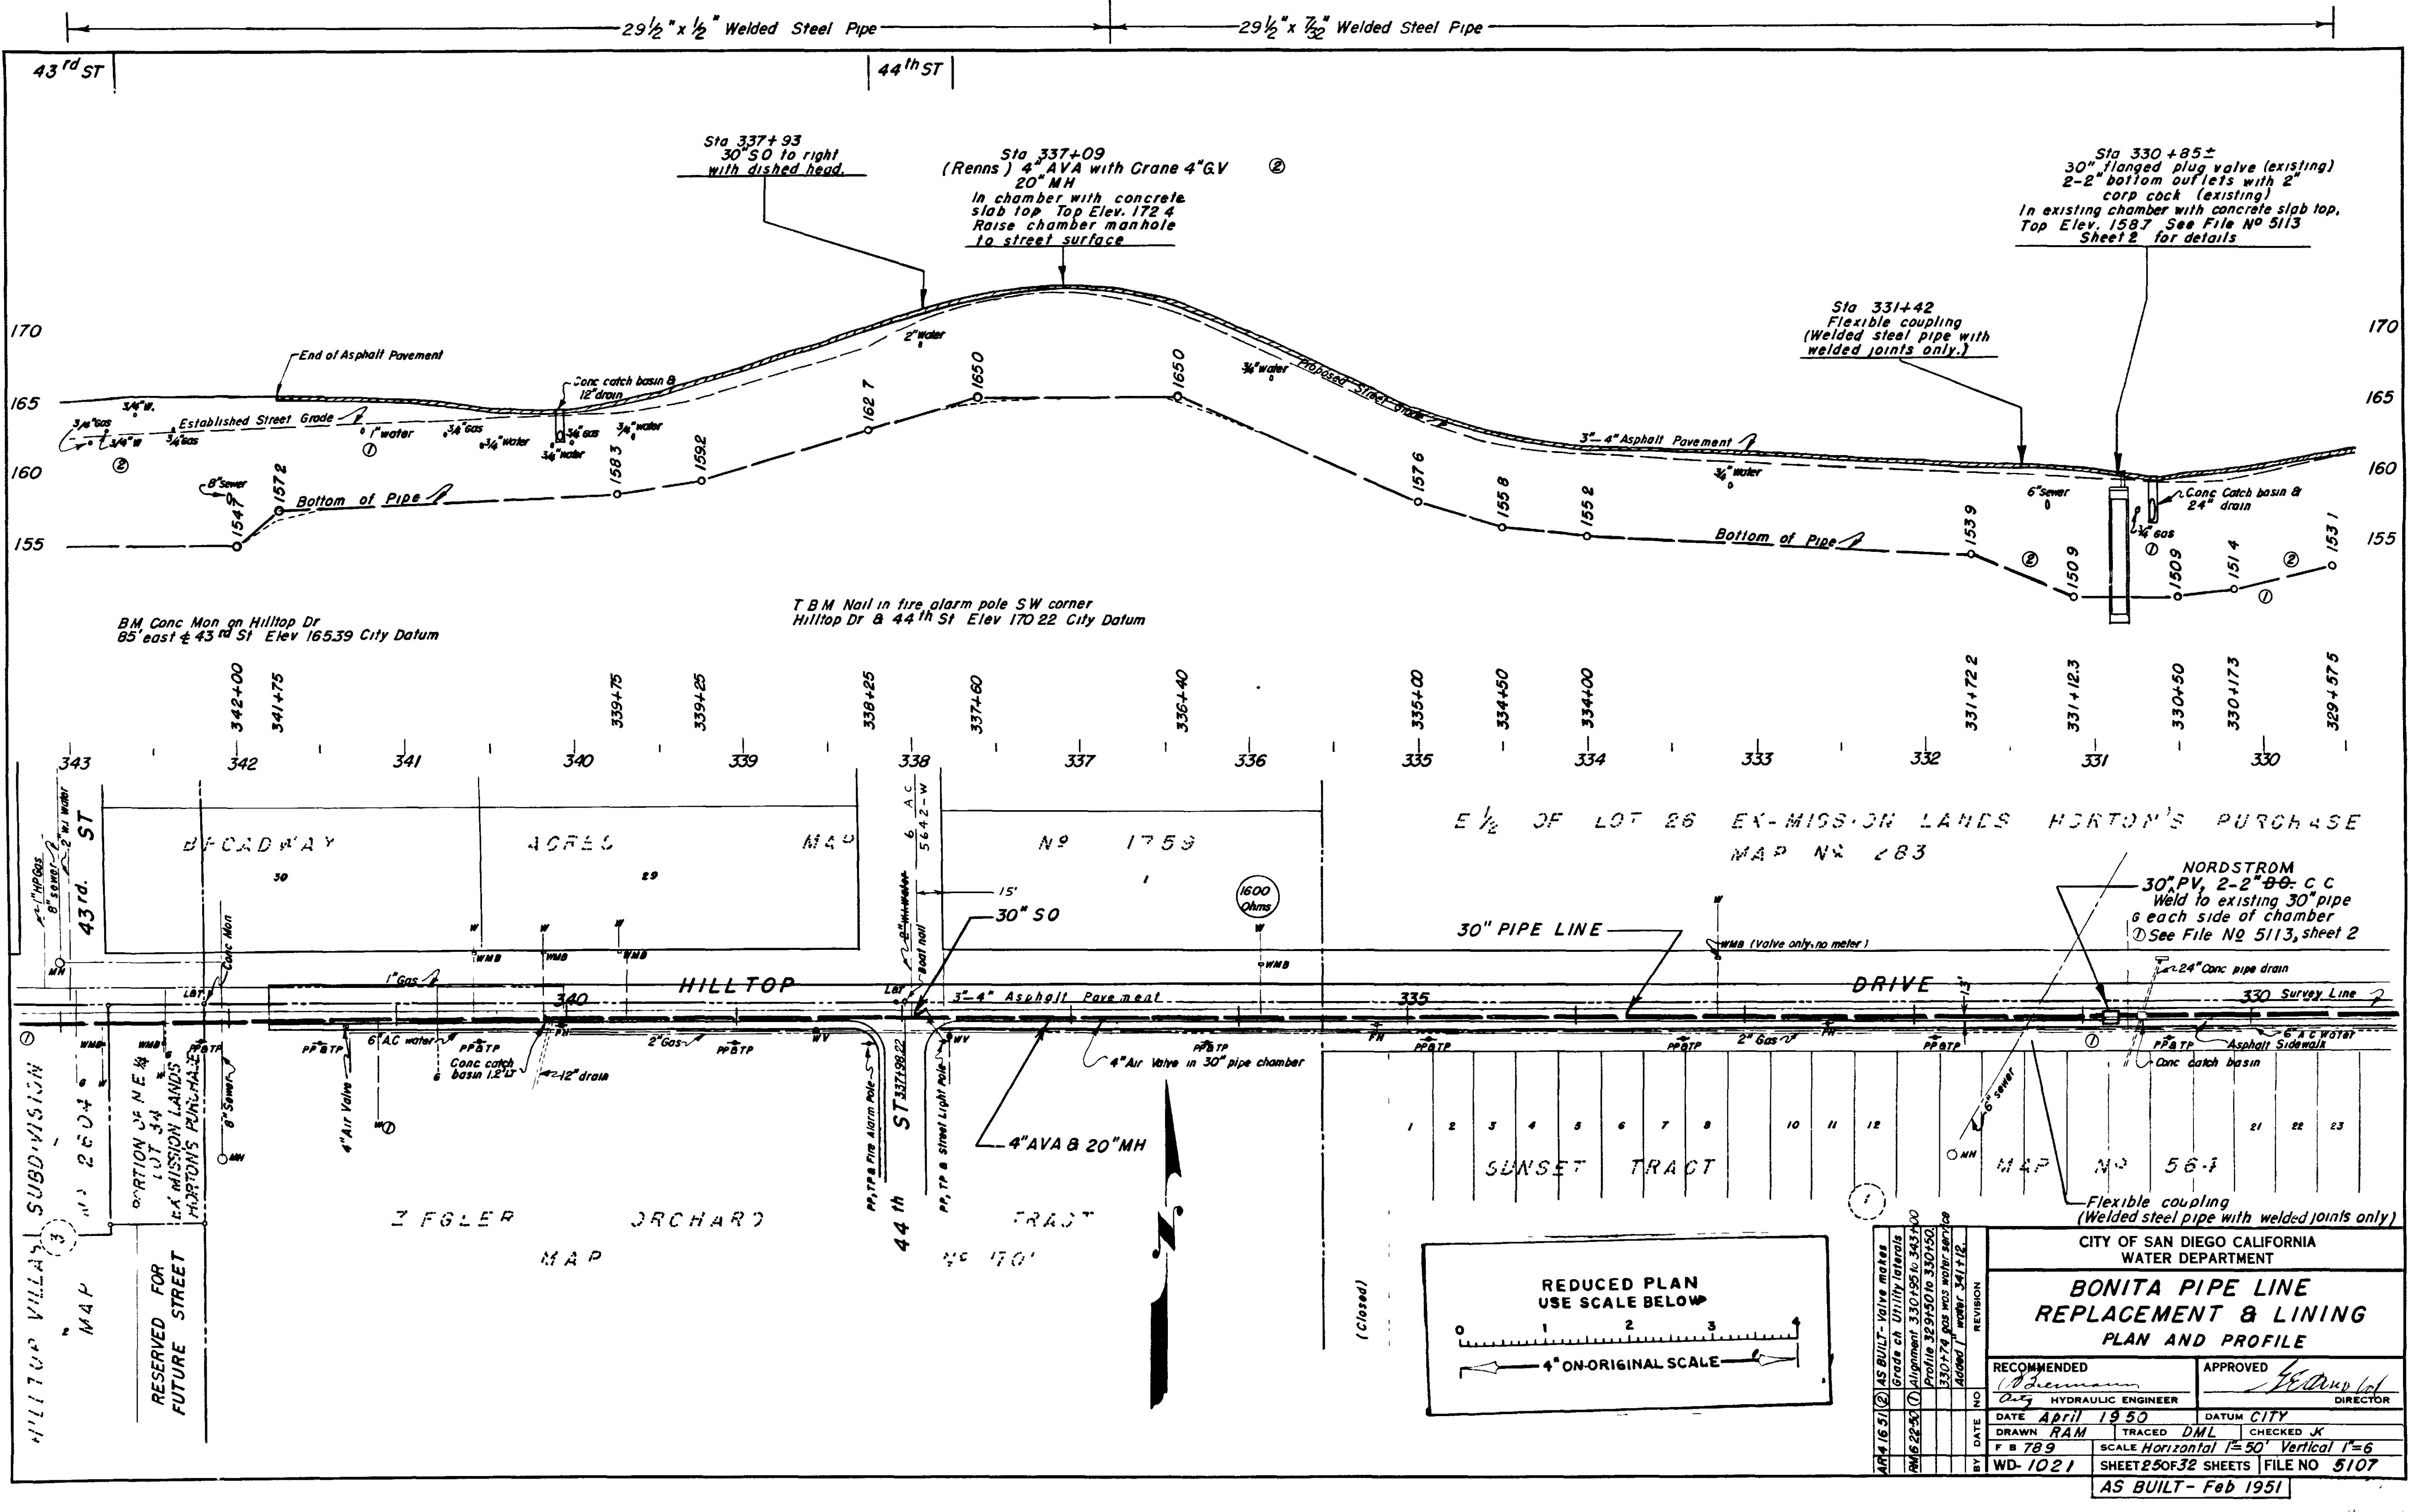

AS BUILT - Valve makes		REVISION	
Grade ch Utility laterals		NO	
Alignment 330+95 to 343+00		DATE	
Profile 329+50 to 330+50		April 19 50	
330+74 gas was water service		DRAWN	
Added 1" water 341+12		RAM	
		DATE	
		April 19 50	
		BY	
		WD-1021	
		CHECKED	
		DML	
		SCALE	
		Horizontal 1"=50' Vertical 1"=6'	
		SHEET 25 OF 32 SHEETS	
		FILE NO 5107	
AS BUILT - Feb 1951			

CITY OF SAN DIEGO CALIFORNIA WATER DEPARTMENT	
BONITA PIPE LINE REPLACEMENT & LINING PLAN AND PROFILE	
RECOMMENDED J. J. Hermann HYDRAULIC ENGINEER	APPROVED J. E. Dwyer DIRECTOR