
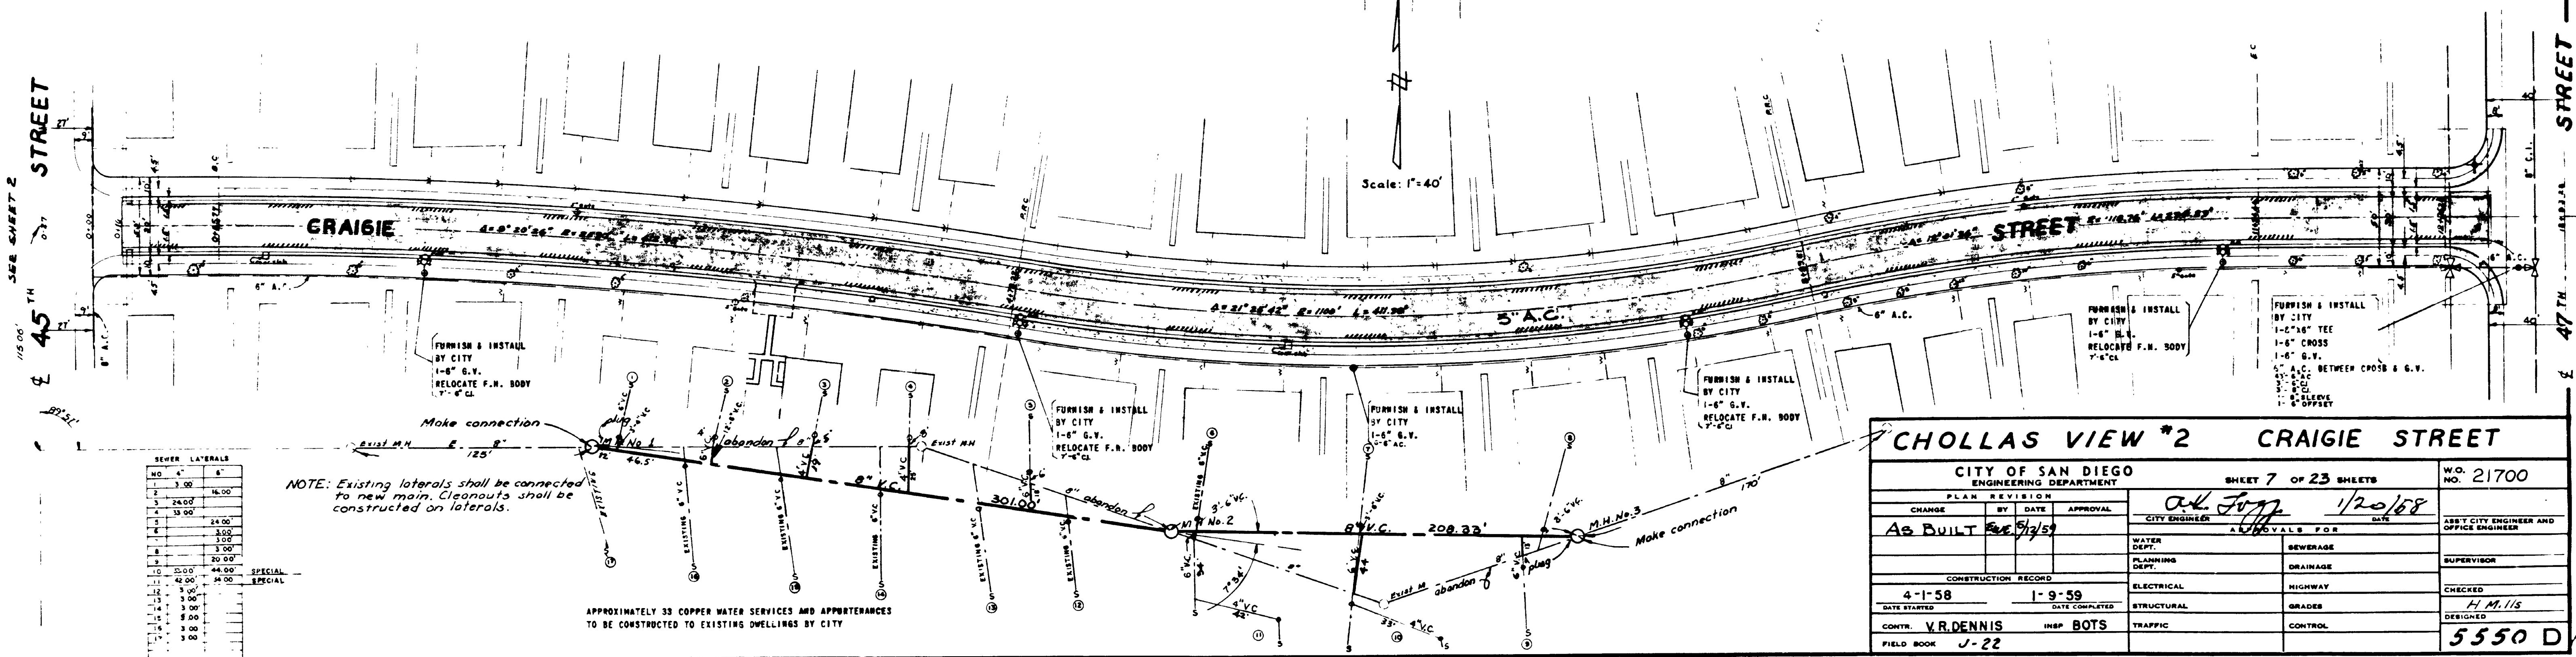


BENCH MARK: N.W. 3.P. 45th St. & Market
Elev. 158.85

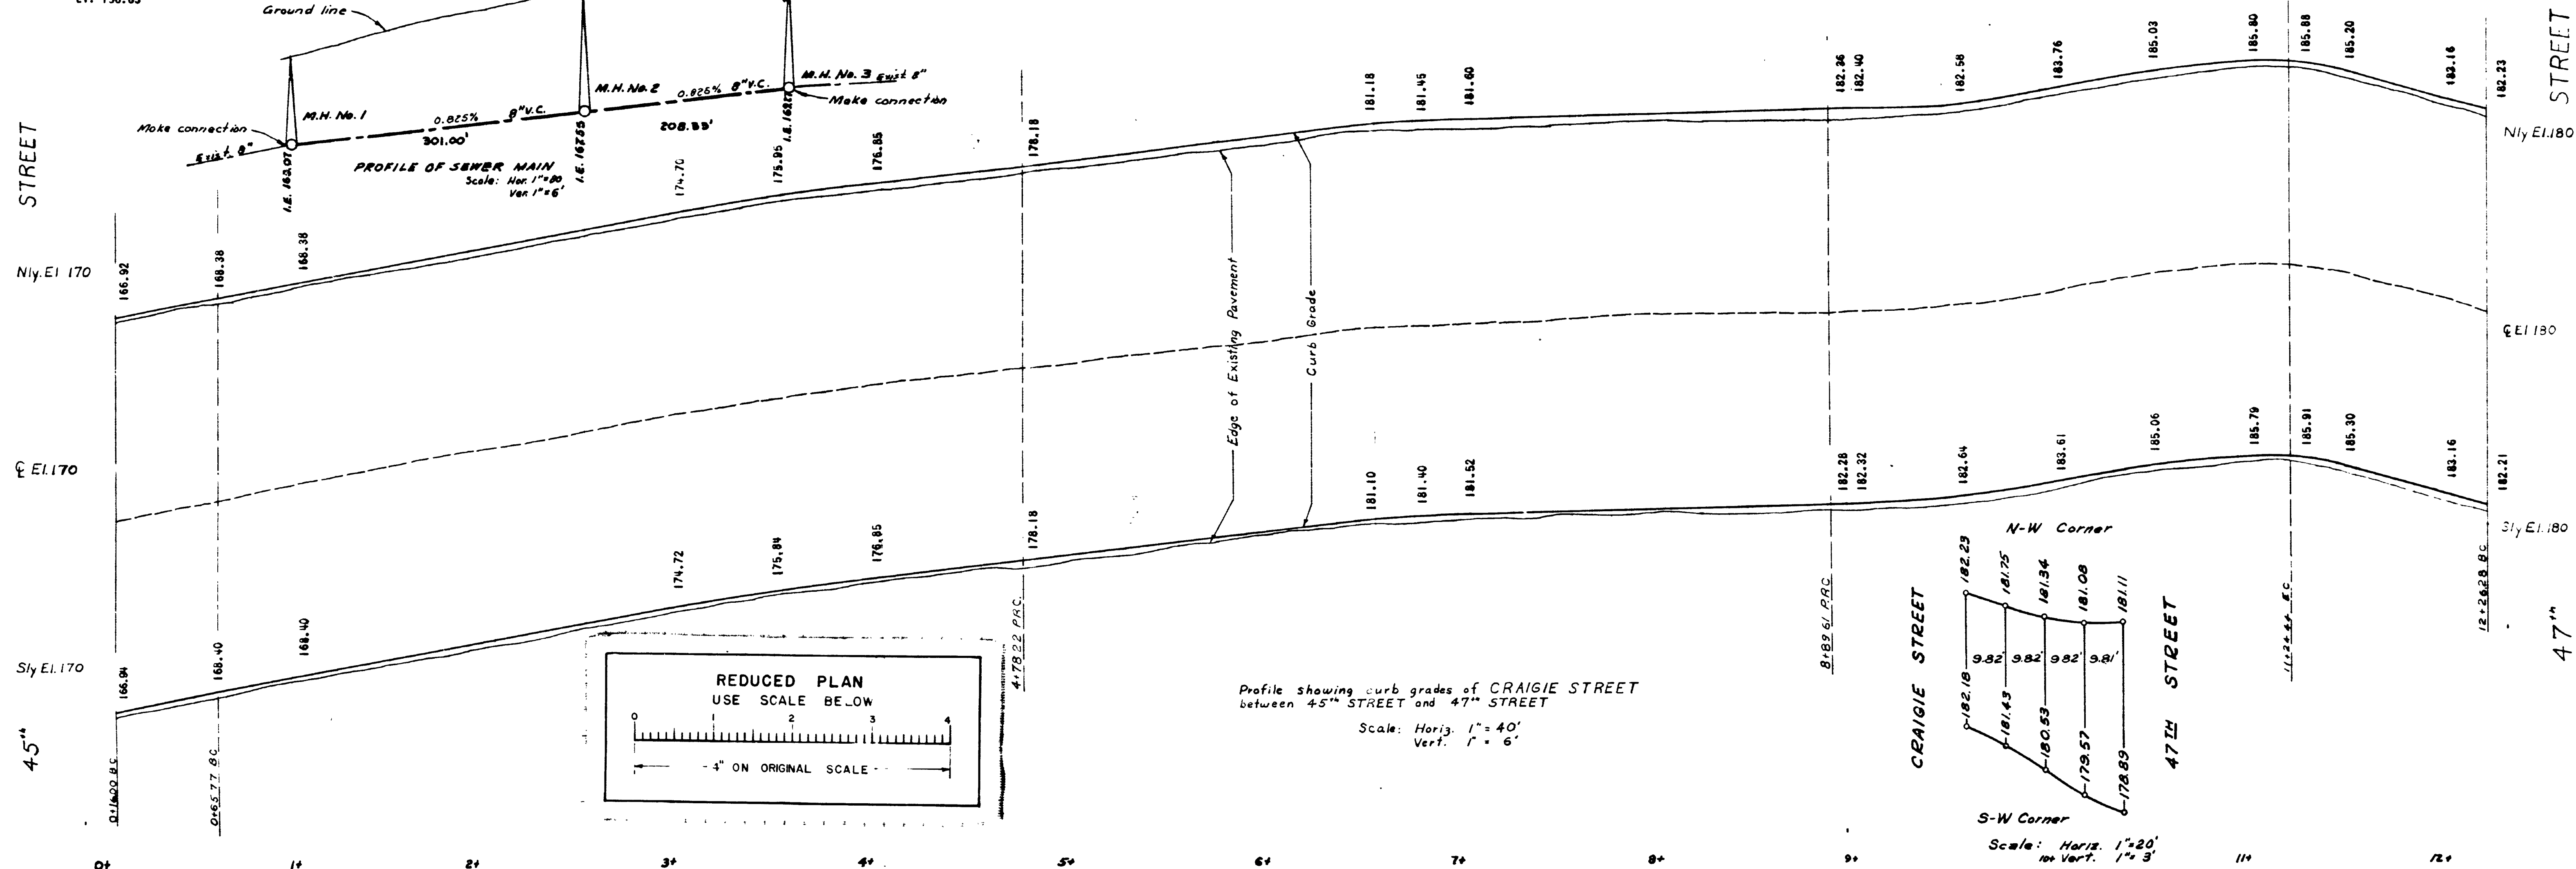

CHOLLAS VIEW #2 CRAIGIE STREET				SHEET 7 OF 23 SHEETS		W.O. NO. 21700	
CITY OF SAN DIEGO ENGINEERING DEPARTMENT				DATE		DATE	
PLAN REVISION				CITY ENGINEER		ASST. CITY ENGINEER AND OFFICE ENGINEER	
CHANGE				DATE		DATE	
AS BUILT				12/20/58			
CONSTRUCTION RECORD				WATER DEPT.		SEWERAGE	
DATE STARTED				PLANNING DEPT.		DRAINAGE	
4-1-58				ELECTRICAL		HIGHWAY	
1-9-59				STRUCTURAL		GRADES	
CONTR. V.R. DENNIS				TRAFFIC		CONTROL	
INSPECTION BOTS							
FIELD BOOK J-22							