

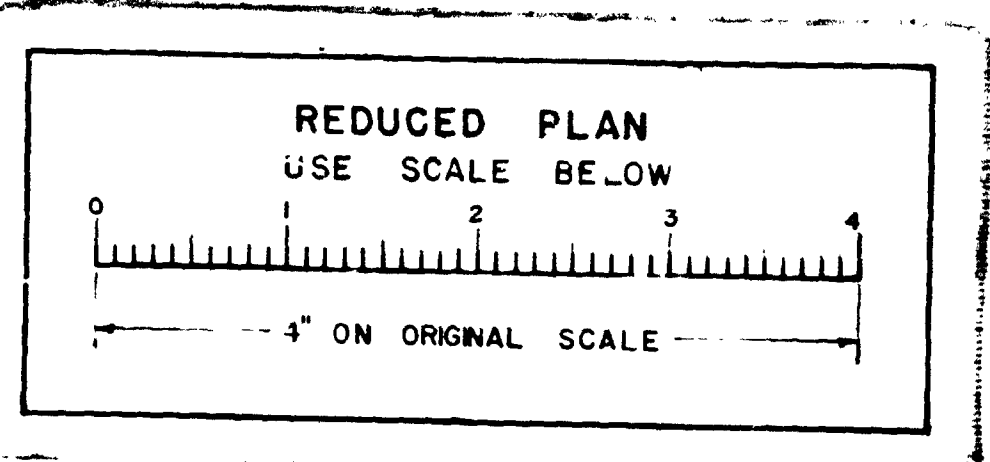


BENCH MARK: N.E.B.P. 44th St. & Market
El. 141.05

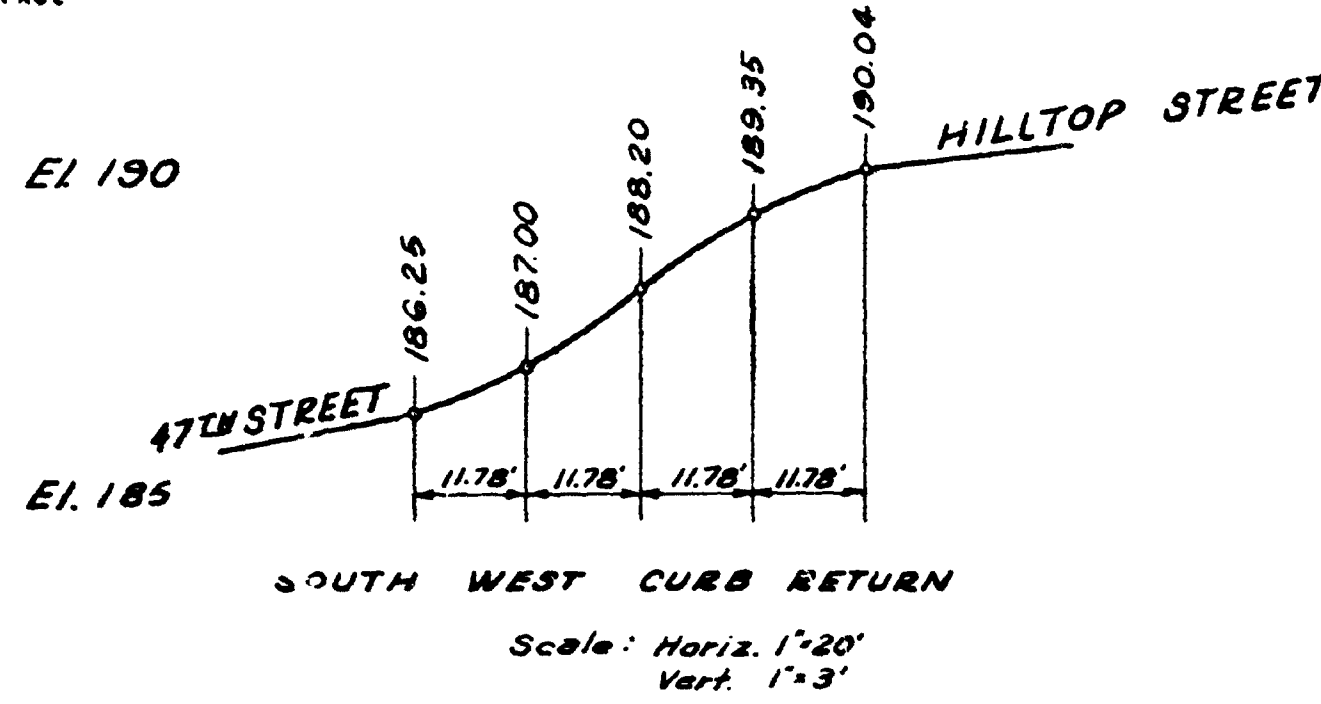

Profile showing curb grade of HILLTOP DRIVE

Scale: Horiz. 1"=40'
Vert. 1"=6'

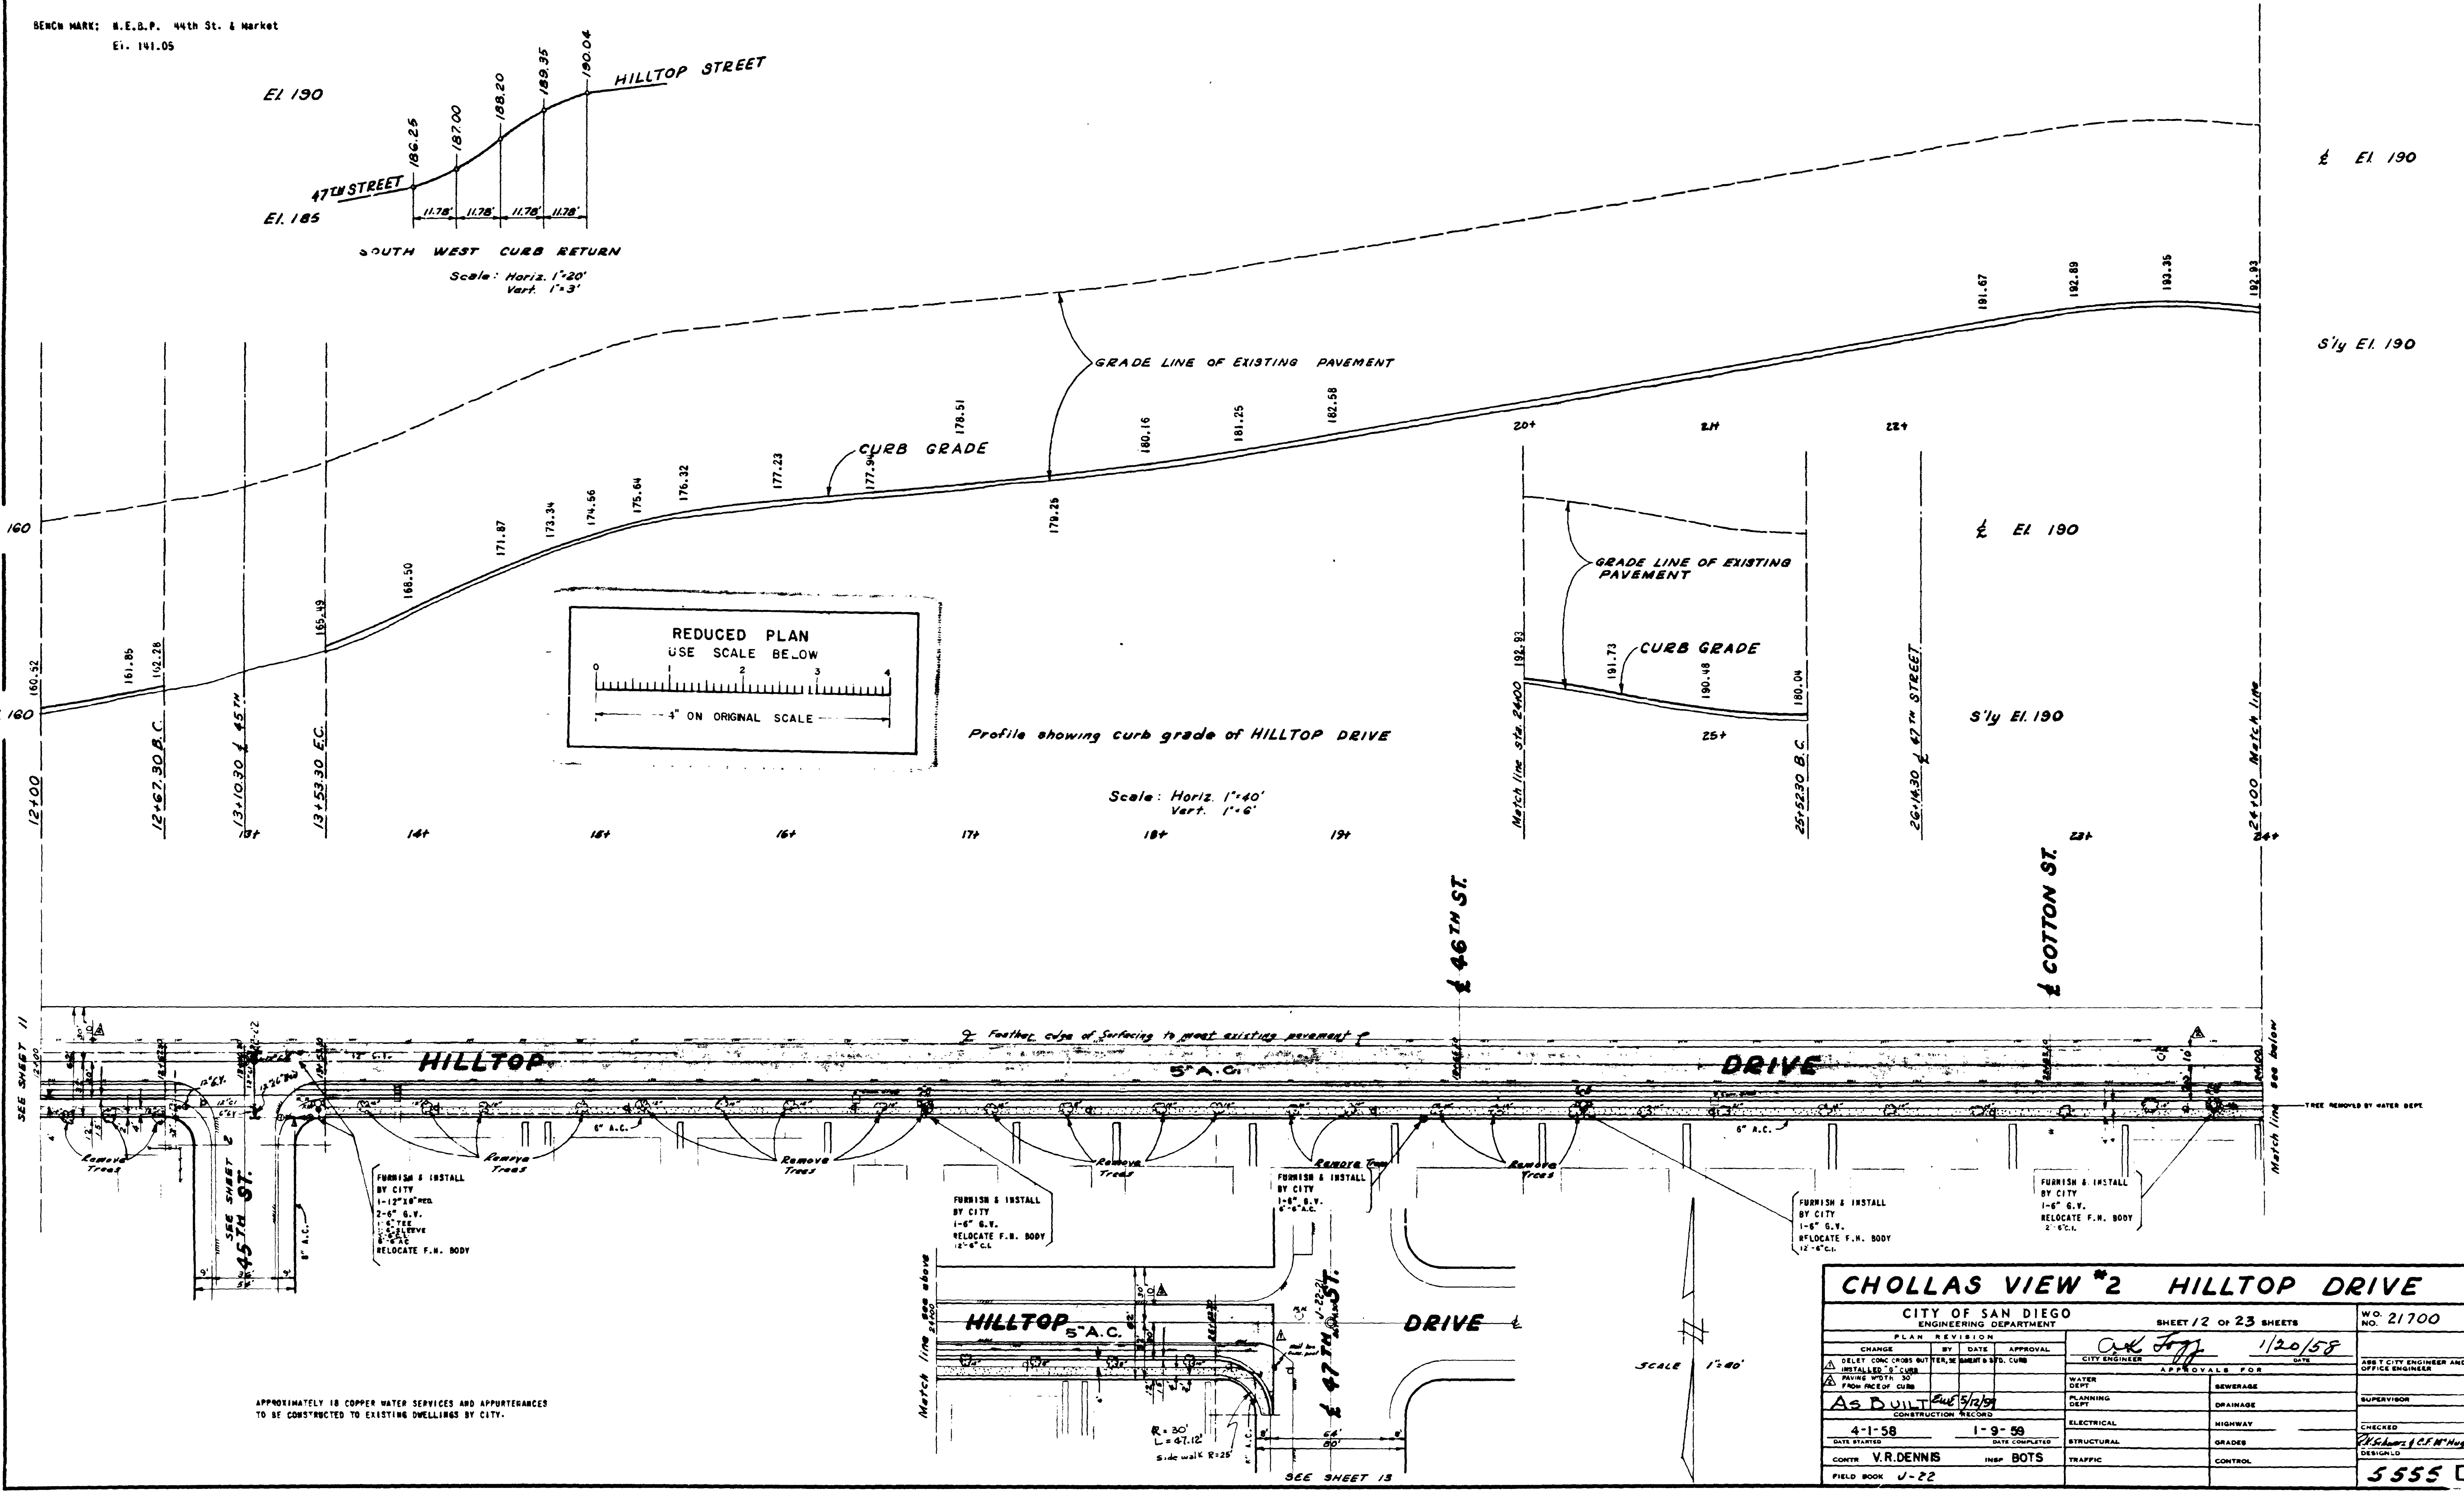

APPROXIMATELY 10 COPPER WATER SERVICES AND APPURTENANCES
TO BE CONSTRUCTED TO EXISTING DWELLINGS BY CITY.

CHOLLAS VIEW #2 HILLTOP DRIVE			
CITY OF SAN DIEGO			
ENGINEERING DEPARTMENT			
SHEET 12 OF 23 SHEETS		NO. 21700	
PLAN REVISION		DATE 1/20/58	
CHANGE	BY	DATE	APPROVAL
DELET CONCR CROSS BUTTER, RELOCATE F.N. BODY			
INSTALL 2" CURB			
PAVING WITH 30			
FROM FACE OF CURB			
CONSTRUCTION RECORD		APPROVALS FOR	
4-1-58	1-9-58	WATER DEPT.	SEWERAGE
DATE STARTED	DATE COMPLETED	PLANNING DEPT.	DRAINAGE
CONTR V.R.DENNIS	INSP BOTS	ELECTRICAL	HIGHWAY
FIELD BOOK J-22		STRUCTURAL	GRADES
		TRAFFIC	CONTROL