
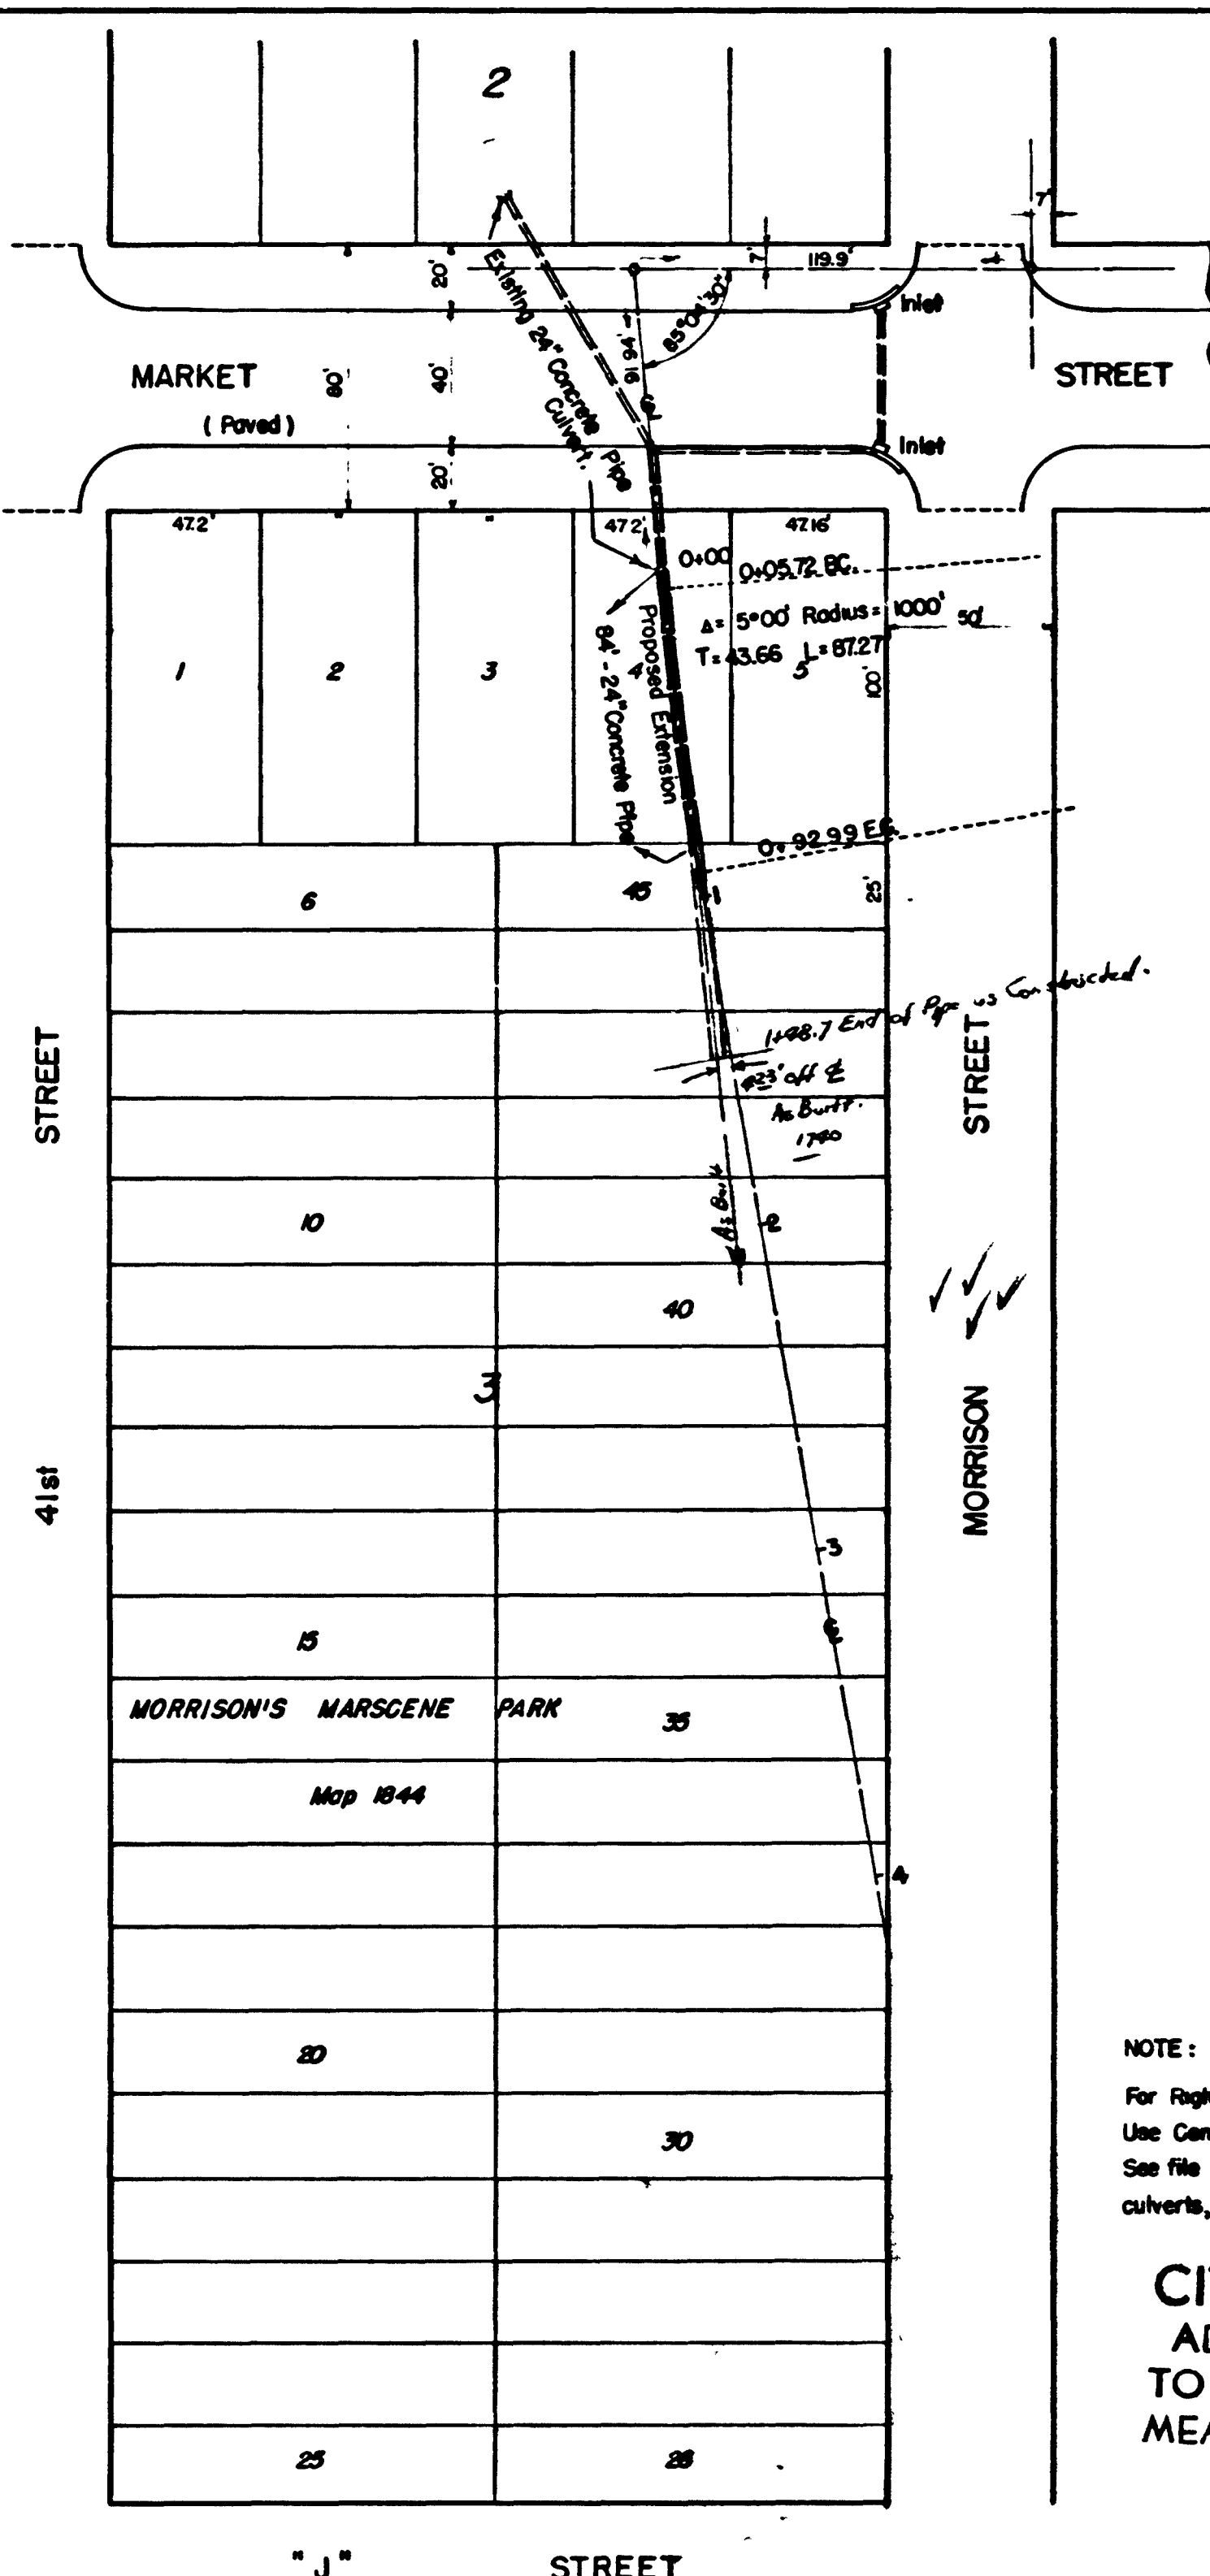


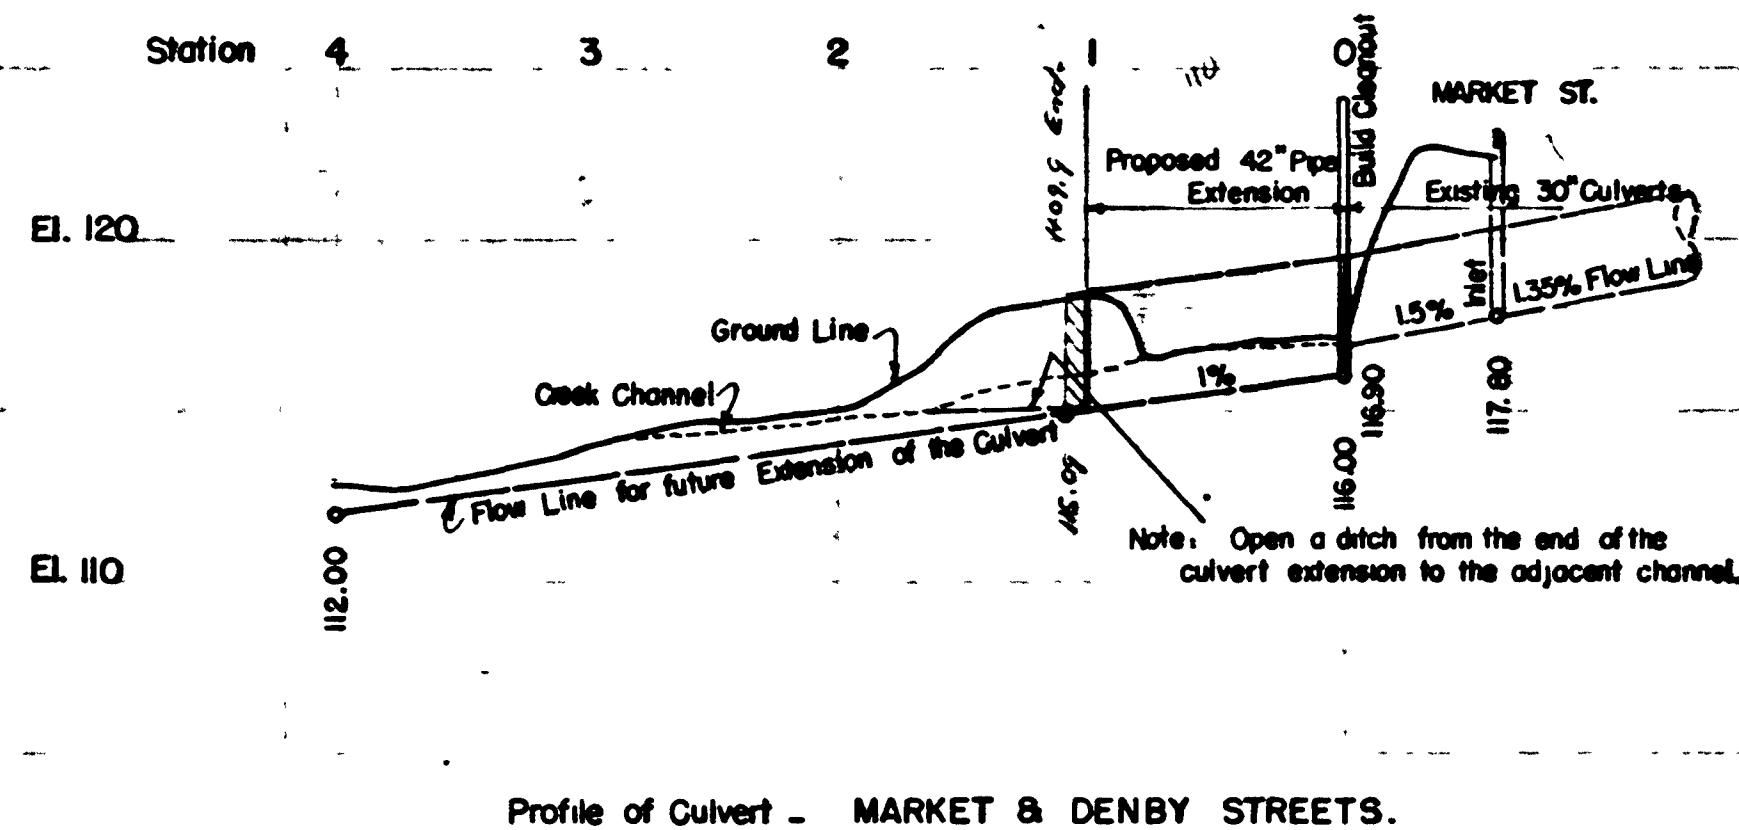

Materials for culvert extensions to be provided by the property owner. Installation to be made by City forces.

Materials for culvert extensions to be provided by the property owner. Installation to be made by City forces.

Statel. G.207/47448 JUL 5 1963

W.O. 20178