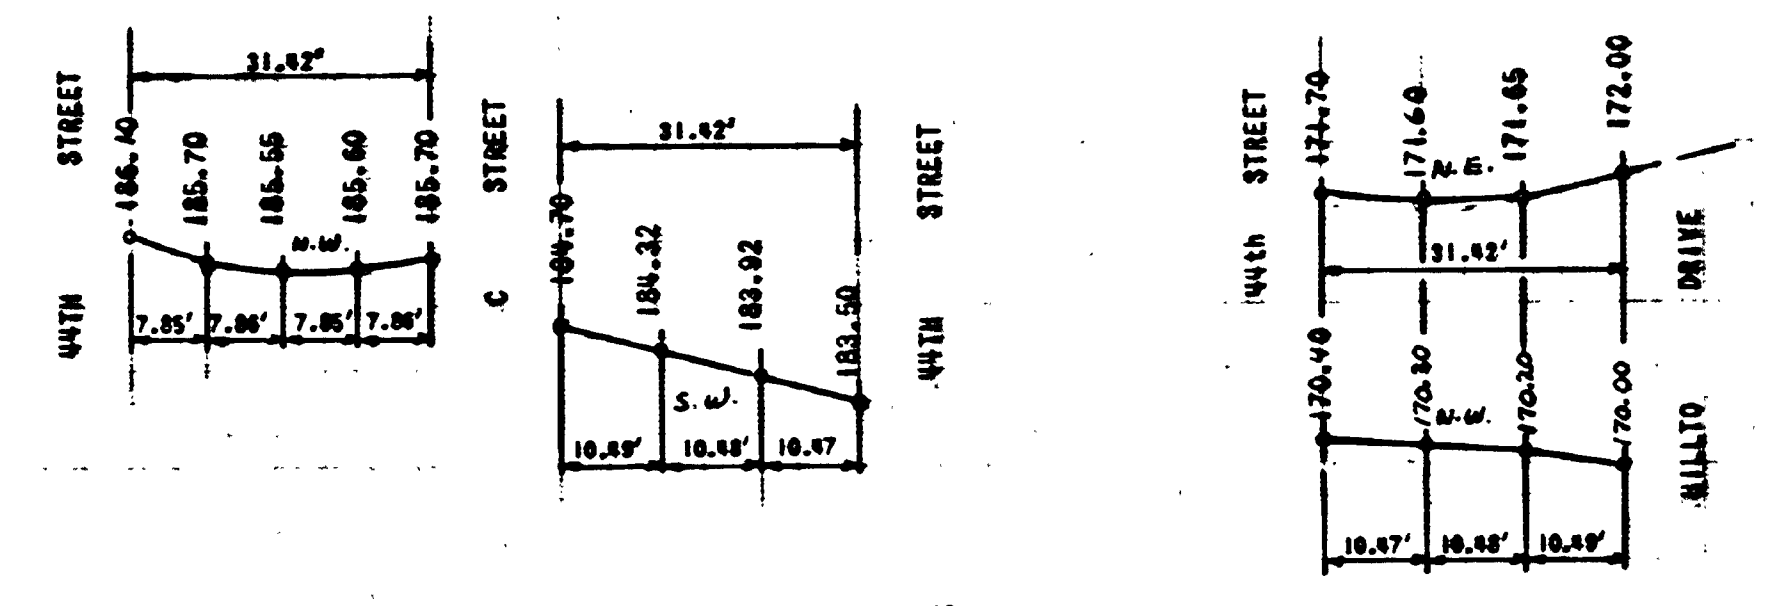
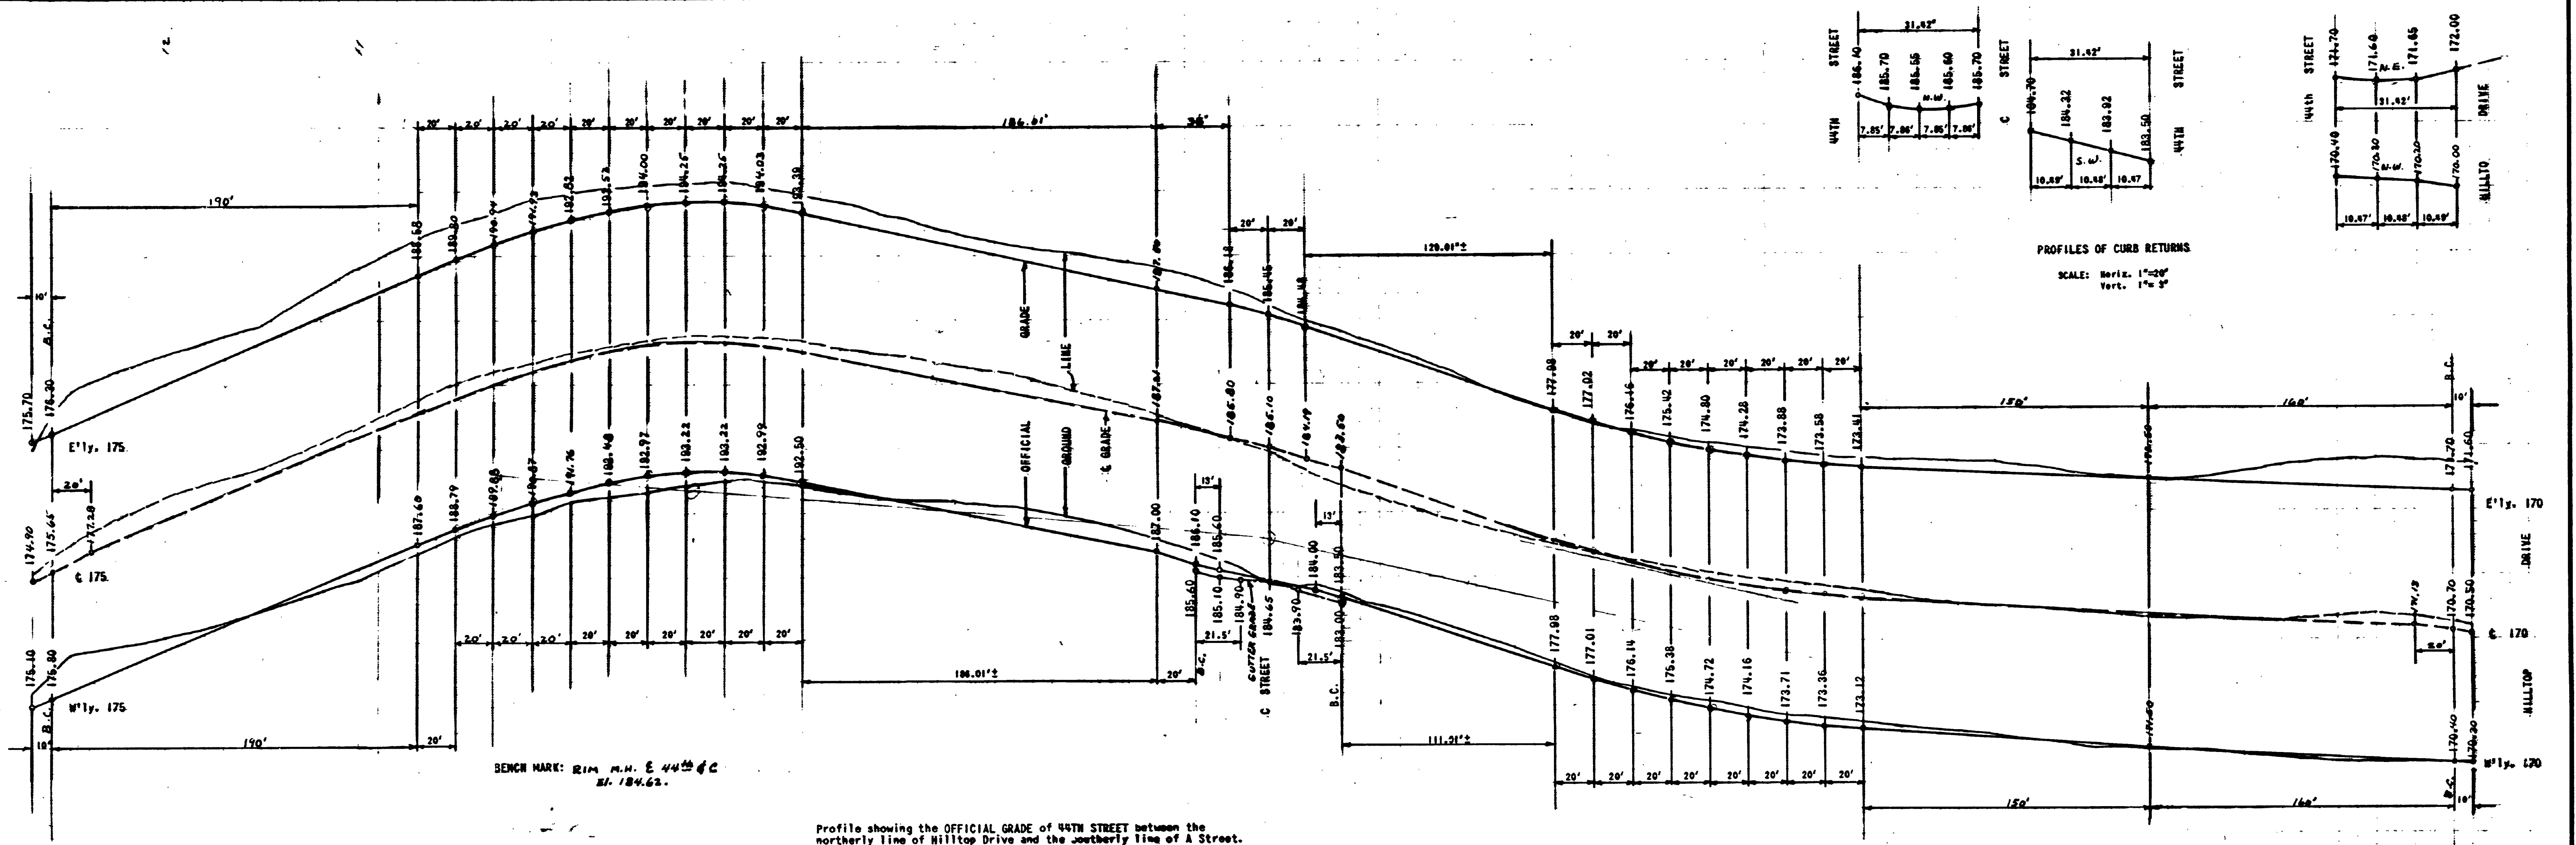


43RD STREET, et.al.				SHEET 3 OF 6 SHEETS		W.O. NO. 32909
CITY OF SAN DIEGO ENGINEERING DEPARTMENT				DATE 9/16/59		ASST CITY ENGINEER AND OFFICE ENGINEER
CHANGE	BY	DATE	APPROVAL	APPROVALS FOR		SUPERVISOR
SEWER LATERAL DELETED				CITY ENGINEER		CHECKED
As BUILT	RE 12-28-60			WATER DEPT.		DESIGNED
CONSTRUCTION RECORD				ELECTRICAL		DE BASS
5-2-60		8-12-60		HIGHWAY		7589 - D
DATE STARTED		DATE COMPLETED		STRUCTURAL		
CONTR. GRIFFITH CO., INC.	INSPECTOR SCOTSE			TRAFFIC		
FIELD BOOK J-22				CONTROL		