


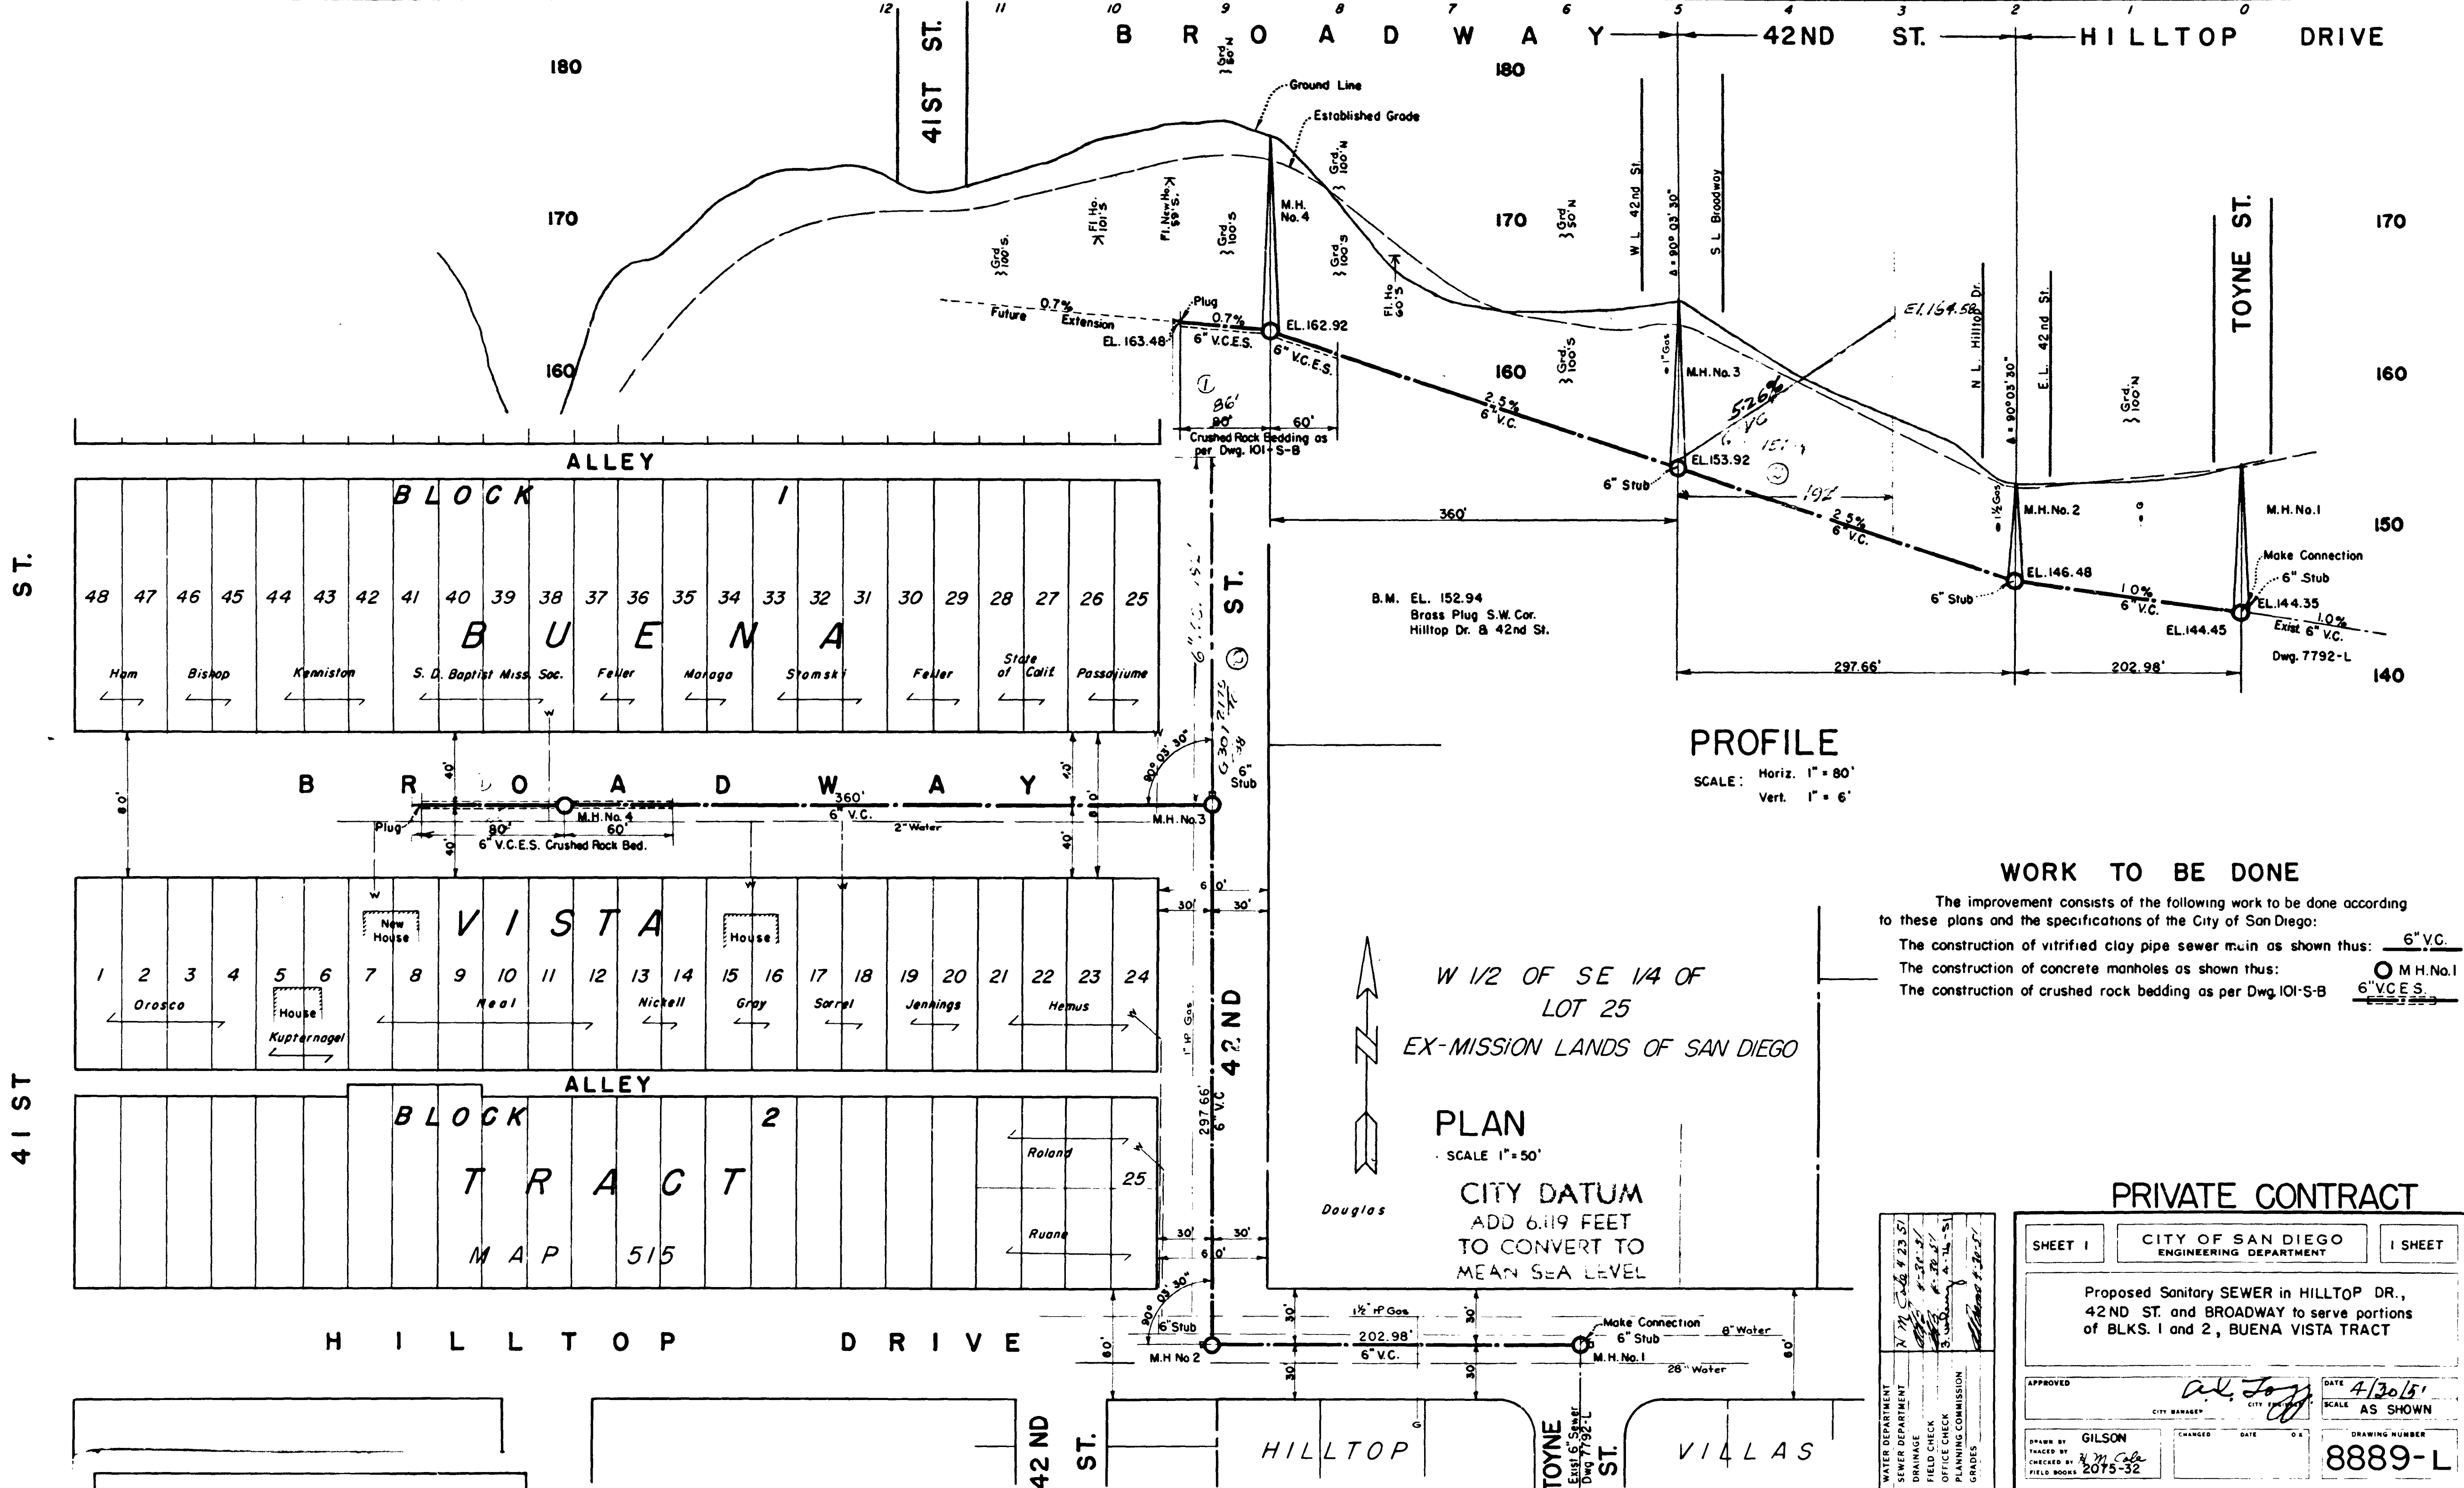

PROFILE

SCALE: Horiz. 1" = 80'
Vert. 1" = 6'

WORK TO BE DONE

The improvement consists of the following work to be done according to these plans and the specifications of the City of San Diego:
The construction of vitrified clay pipe sewer main as shown thus: 6" V.C.
The construction of concrete manholes as shown thus: M.H. No. 1
The construction of crushed rock bedding as per Dwg. 101-S-B 6" V.C.E.S.

PLAN

SCALE 1" = 50'

CITY DATUM
ADD 6.119 FEET
TO CONVERT TO
MEAN SEA LEVEL

PRIVATE CONTRACT

SHEET 1 CITY OF SAN DIEGO ENGINEERING DEPARTMENT 1 SHEET


Proposed Sanitary SEWER in HILLTOP DR.,
42ND ST. and BROADWAY to serve portions
of BLKS. 1 and 2, BUENA VISTA TRACT

APPROVED: [Signature] DATE: 4/30/51
CITY ENGINEER: [Signature] SCALE: AS SHOWN

DRAWN BY: GILSON
CHECKED BY: [Signature]
DATE: 6-7-51
DRAWING NUMBER: 8889-L

CONSTRUCTION RECORD
CONTRACTOR: PAGE
INSPECTOR: KNUDSEN
DATE STARTED: 6-7-51
DATE COMPLETED: 6-20-51
REVISIONS: 1
DATE: 7-17-51 BY: N

REDUCED PLAN
USE SCALE BELOW

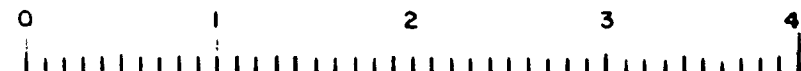

1" ON ORIGINAL SCALE