


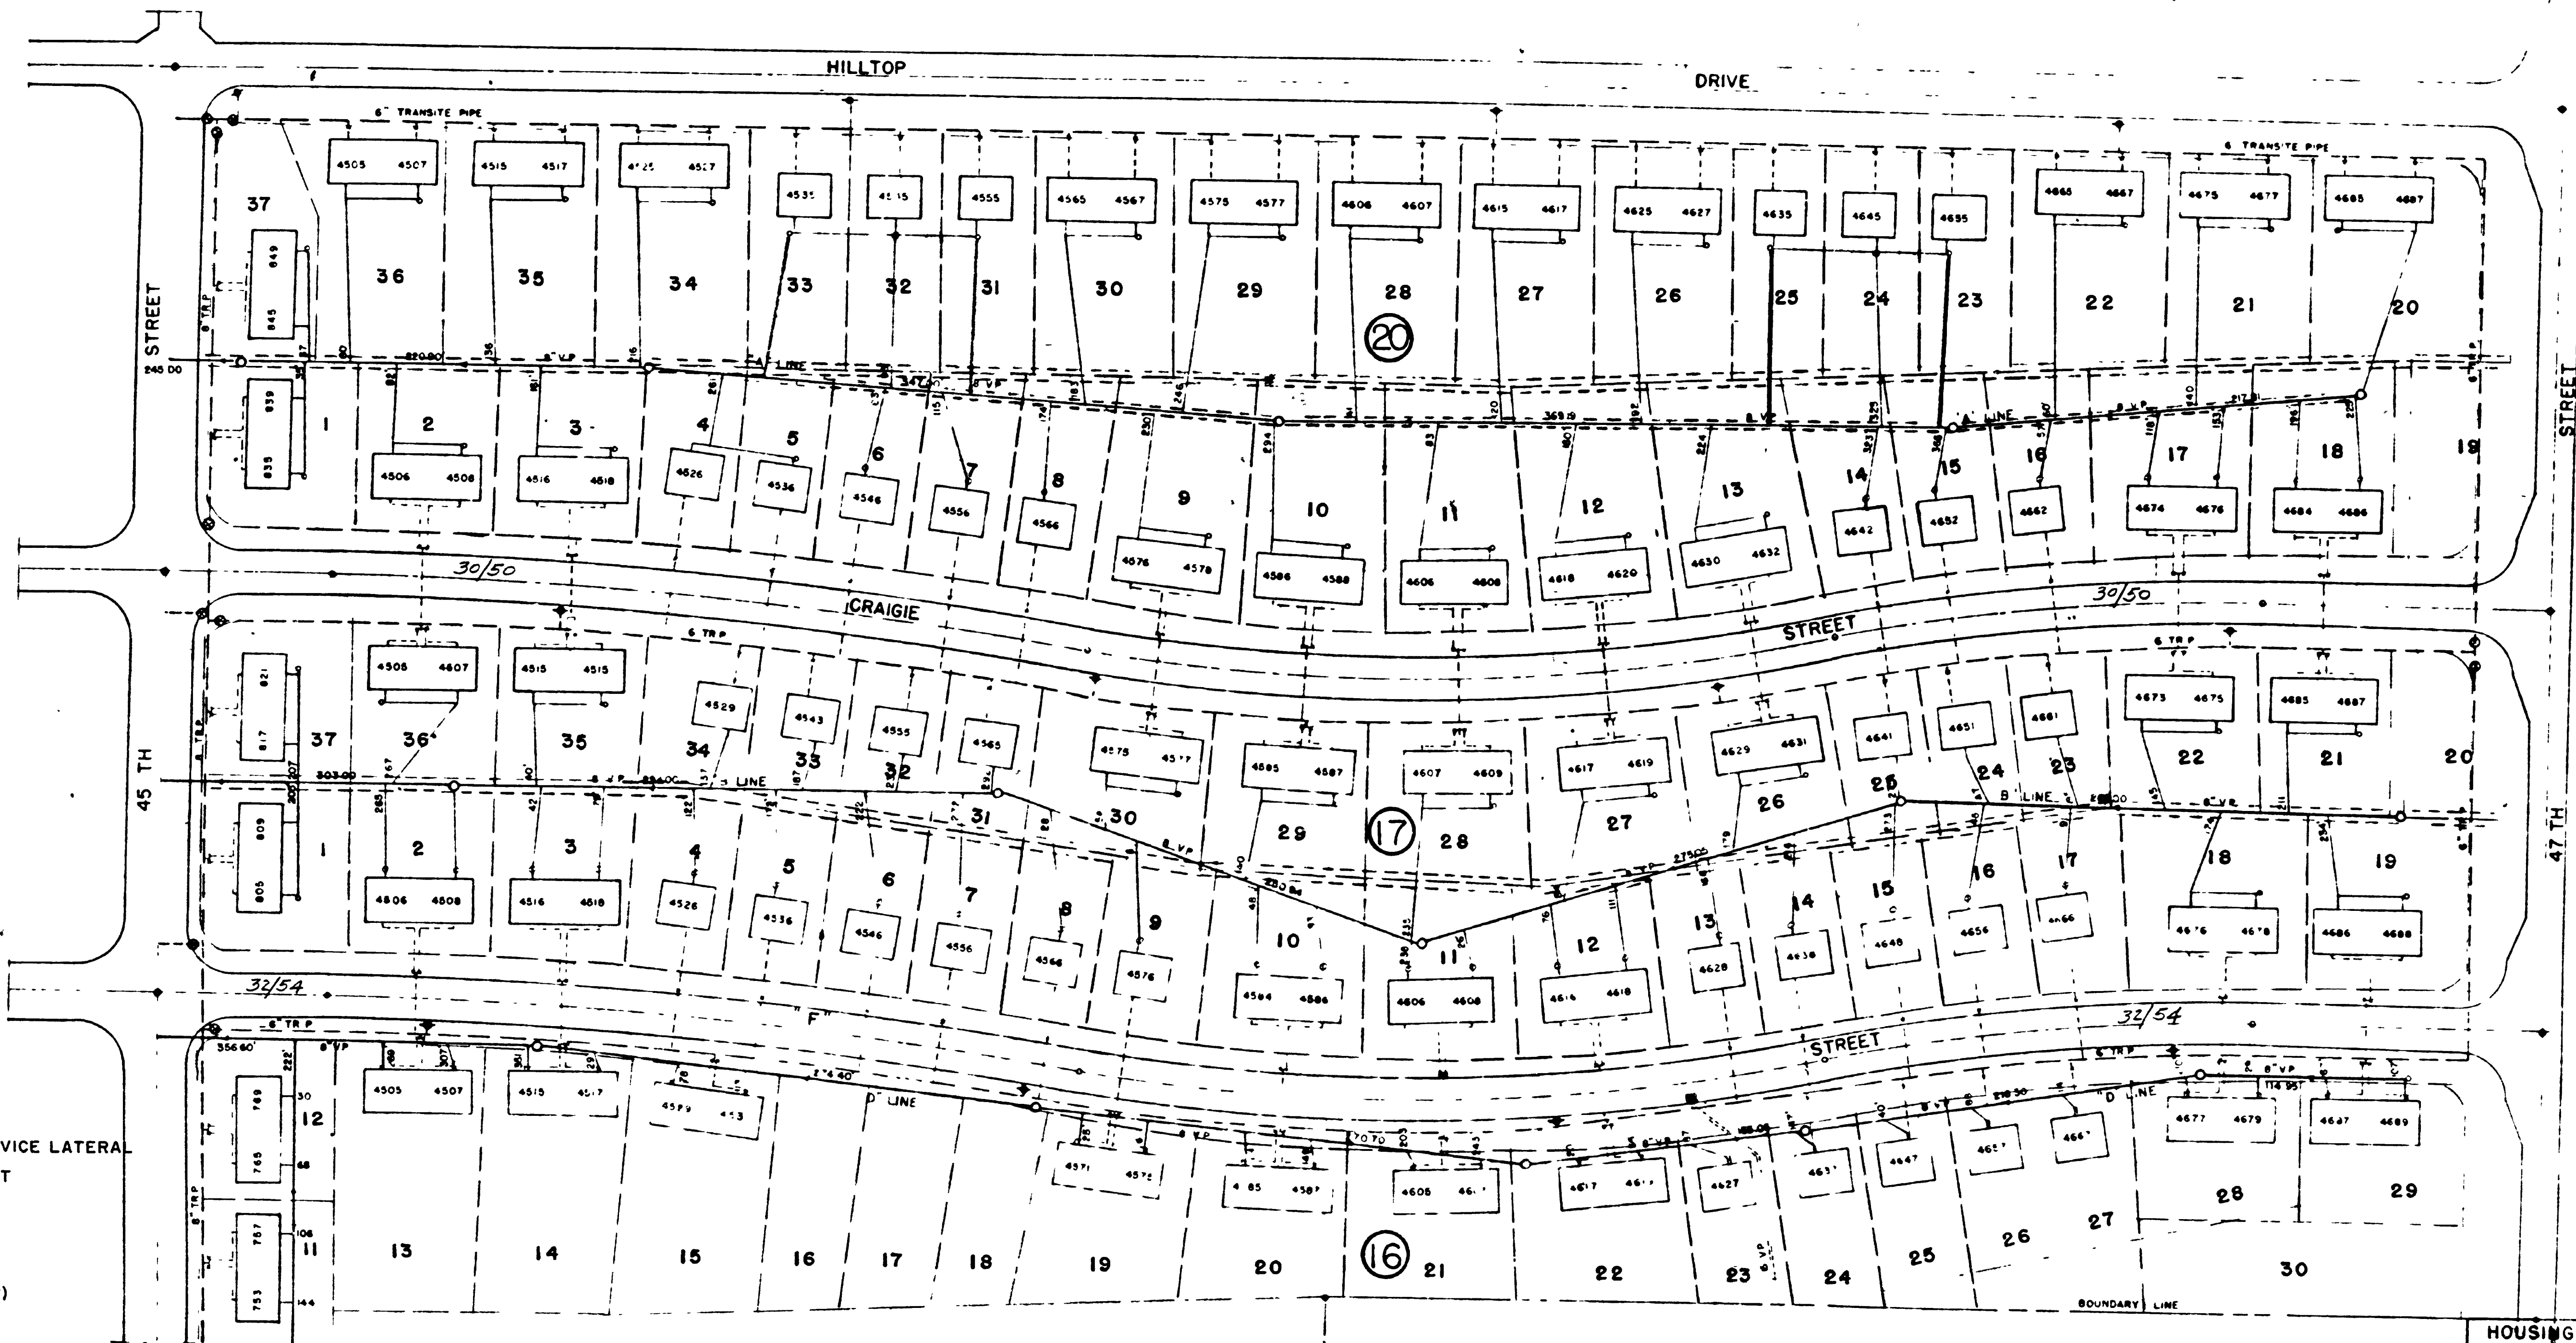

LEGEND


- NEW SEWER SERVICE LATERAL
- SEWER CLEANOUT
- LOT LINES
- SEWER LINES
- WATER LINES
- VALVES (WATER)
- FIRE HYDRANTS
- MANHOLES

NOTE

ANY SEWER LATERAL ENCRANCHING
ON AN ADJACENT LOT WILL BE
PROTECTED BY AN EASEMENT.

SEE PLOT FOR LOT DIMENSIONS

REDUCED PLAN
USE SCALE BELOW

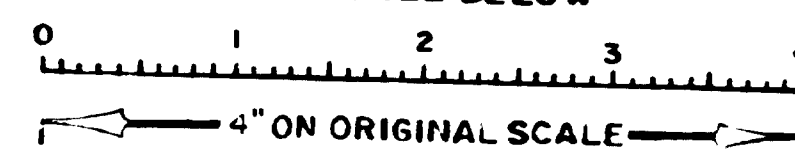

HOUSING AND HOME FINANCE AGENCY
PUBLIC HOUSING ADMINISTRATION
SAN DIEGO, CALIF.
PROJECT CAL-4097X CHOLLAS VIEW
PRELIMINARY LAYOUT
SEWER & WATER MAINS & SERVICES
CHOLLAS VIEW SUBDIVISION UNIT NO. 2
DRAWN BY RHM SCALE 1"=50'
CHECKED BY JFS
APPROVED 12-20-56

[Signature]
12/20/57

D-59

FEDERAL WORKS AGENCY
JOHN M. GARMON

DEFENSE HOUSING PROJECT
No. CAL-4097X SAN DIEGO, CALIFORNIA