


SCALE 1" = 50' HORIZONTAL
1" = 6' VERTICAL

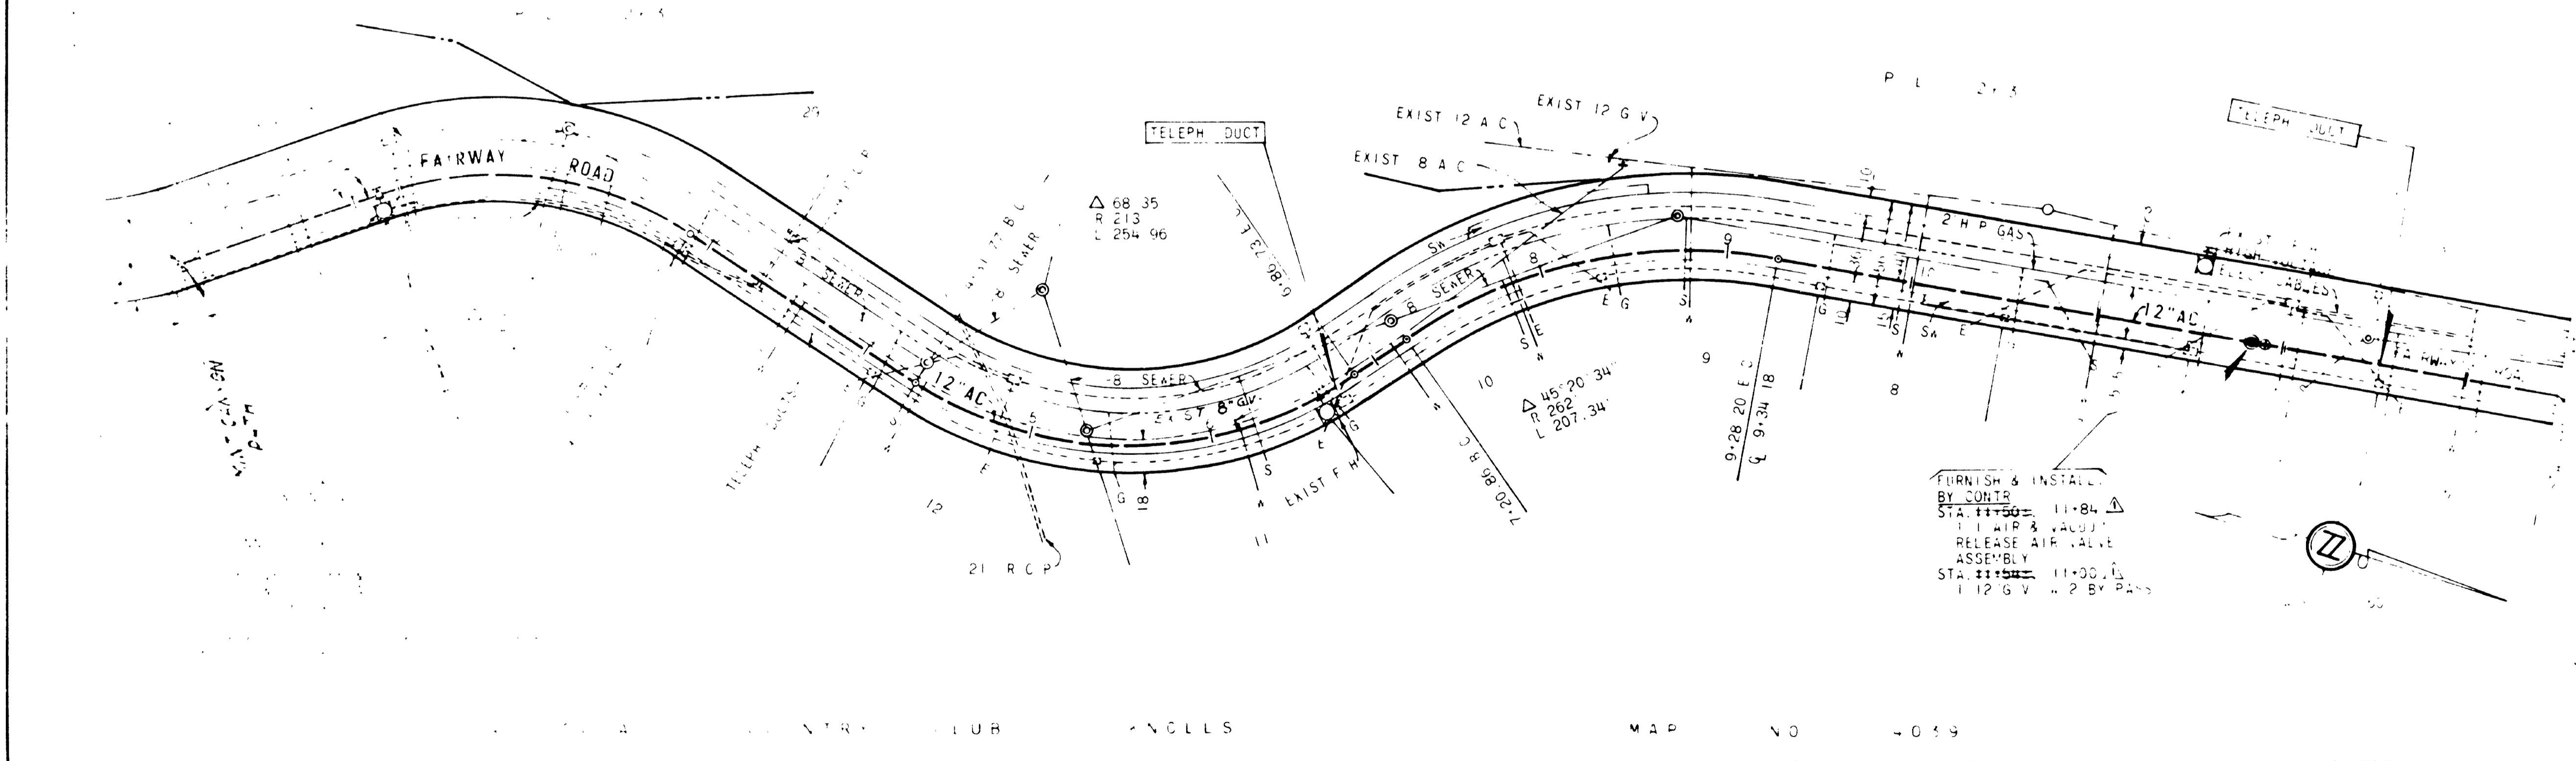

FURNISH & INSTALL
BY CONTRACTOR
STA. 11+50 TO 11+84
12\"/>

FAIRWAY ROAD 2' A.C.	
CITY OF SAN DIEGO, CALIFORNIA	NO. 11
SHEET 1 OF 2 SHEETS	
DESIGNER: J. C. [Signature]	DATE: 11-8-47
DESCRIPTION: ORIGINAL	BY: [Signature]
APPROVED: [Signature]	DATE: 11-10-47
CONTRACTOR: [Signature]	DATE STARTED: [Blank]
INSPECTOR: [Signature]	DATE COMPLETED: 29292-D

FAIRWAY RD.

ASBULL