

**WORK TO BE DONE**  
 The improvement consists of the following work to be done according to these plans and the specifications hereto attached.  
 The construction of vitrified clay pipe sewer main as shown there;  
 The construction of concrete manholes as shown there;  
 The construction of vitrified clay pipe sewer chimneys as shown there;  
 The construction of concrete curbs as shown there.

**LEGEND - EXISTING WORK**  
 Type 6 curb  
 Sanitary sewer main  
 Manholes  
 Water main  
 Gas main  
 Gas service  
 Edge of pavement


**LEGEND**  
 Property division by deed  
 Property ownership

**REFERENCE DRAWINGS**  
 1031-21 sheet 2124  
 1027 File Map  
 R.O.S. Agreement Map Book 2, Page 107

**STANDARD DRAWINGS**  
 100-28, 6/1/53  
 101-58, 6/1/53  
 107-58  
 108-58 1/11/54  
 109-58 5/1/54

**NOTES**  
 V.G. means Vitrified clay  
 E.S. means Extra strength  
 A.C. means Asphalt concrete  
 T.A.C. means Transite asbestos clay  
 H.P. means High pressure

**SPECIFICATIONS**  
 Standard Specifications filed July 7, 1954

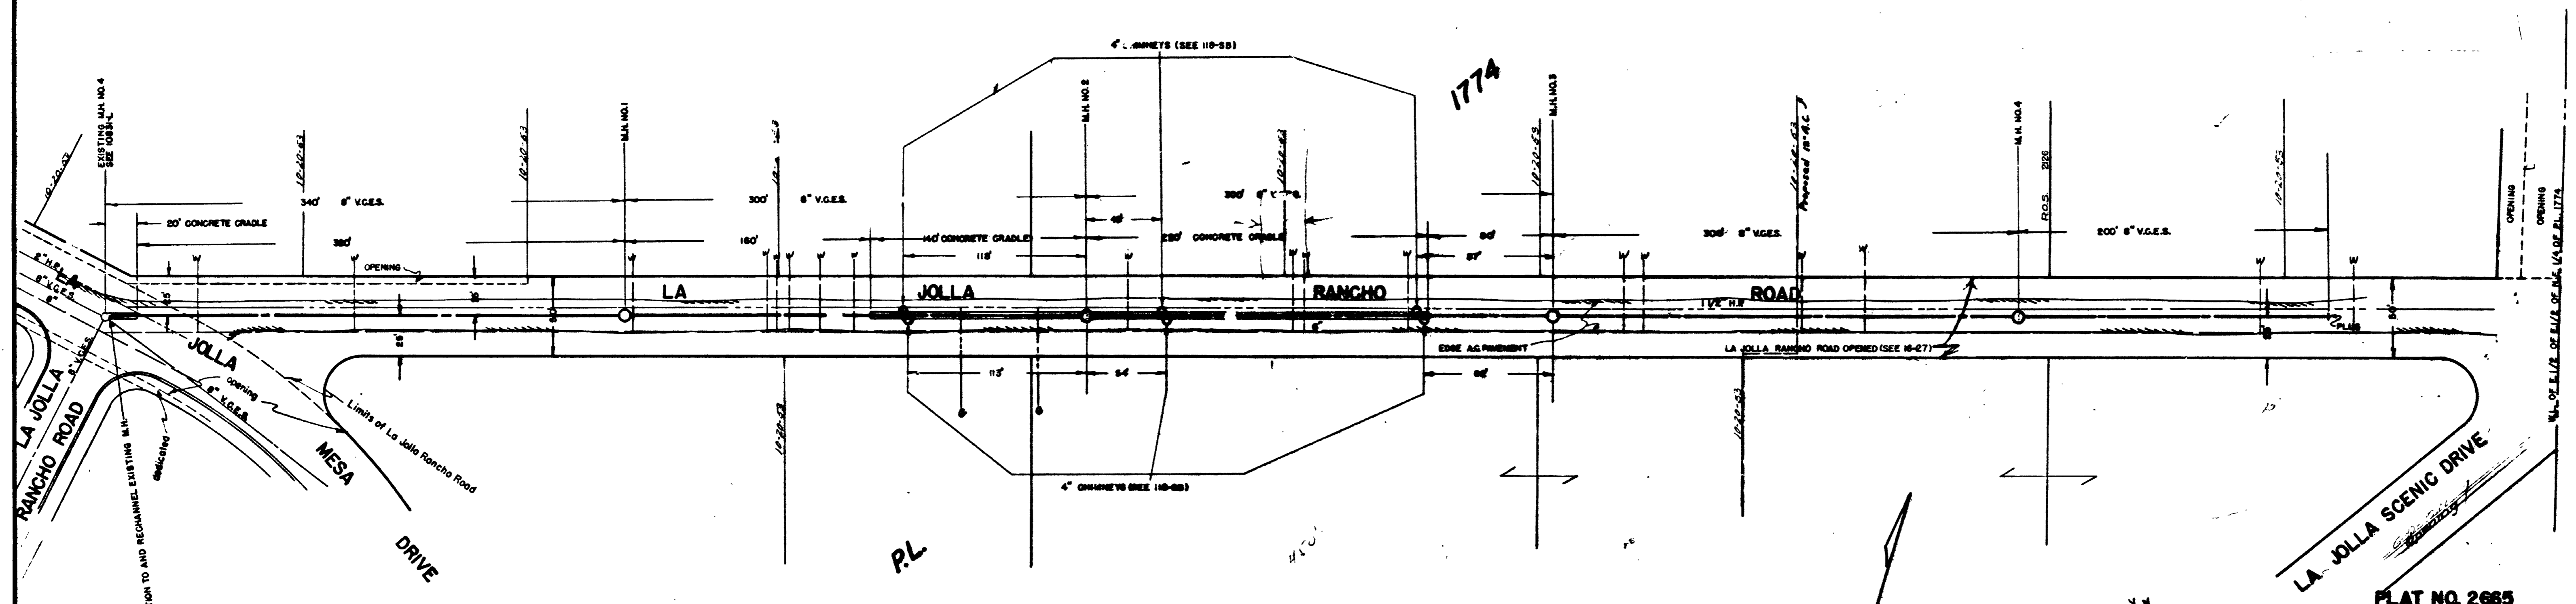

**FLAT NO. 2665**

**CITY OF SAN DIEGO**  
 ENGINEERING DEPARTMENT

Plans for the construction of sanitary sewers in LA JOLLA RANCHO ROAD between the southwestern line of La Jolla Mesa Drive and the southern prolongation of the westerly line of La Jolla Scenic Drive.

DATE: 7/10/52  
 SCALE: AS SHOWN  
 2741-D

CONSTRUCTION RECORD  
 W. O. B. 2665  
 6-22-52  
 10-4-52