


LA JOLLA COUNTRY CLUB KNOLLS

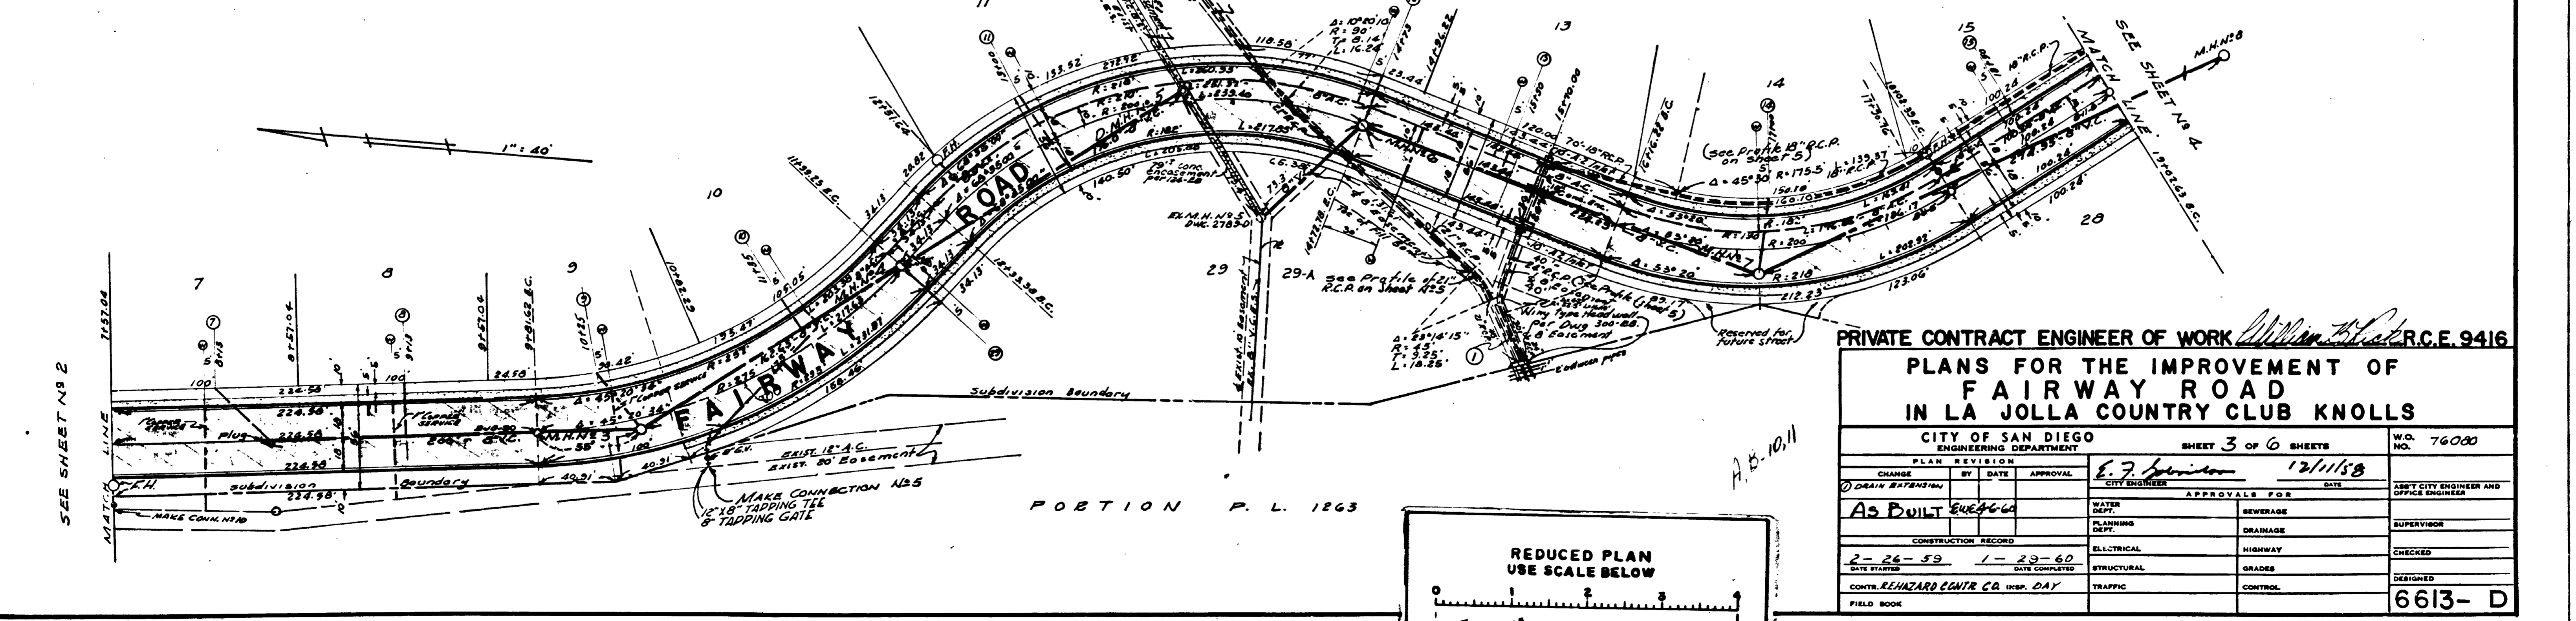

PRIVATE CONTRACT ENGINEER OF WORK *William H. Baker* R.C.E. 9416

PLANS FOR THE IMPROVEMENT OF FAIRWAY ROAD IN LA JOLLA COUNTRY CLUB KNOLLS

CITY OF SAN DIEGO ENGINEERING DEPARTMENT		SHEET 3 OF 6 SHEETS	W.D. NO. 76000
PLAN REVISION		E. J. Levinson 12/11/58	
CHANGE	BY	DATE	APPROVAL
1 DRAIN EXTENSION			
As Built 8/26/60		APPROVALS FOR	
		WATER DEPT.	SEWERAGE
		PLANNING DEPT.	DRAINAGE
		ELECTRICAL	HIGHWAY
		STRUCTURAL	GRADES
		TRAFFIC	CONTROL
CONSTRUCTION RECORD		CHECKED	
2-26-59 1-29-60		DESIGNED	
DATE STARTED DATE COMPLETED		6613-D	
CONTR. REHAZARD CONTR. CO. INSP. DAY		FIELD BOOK	

MICROFILMED
 1963