


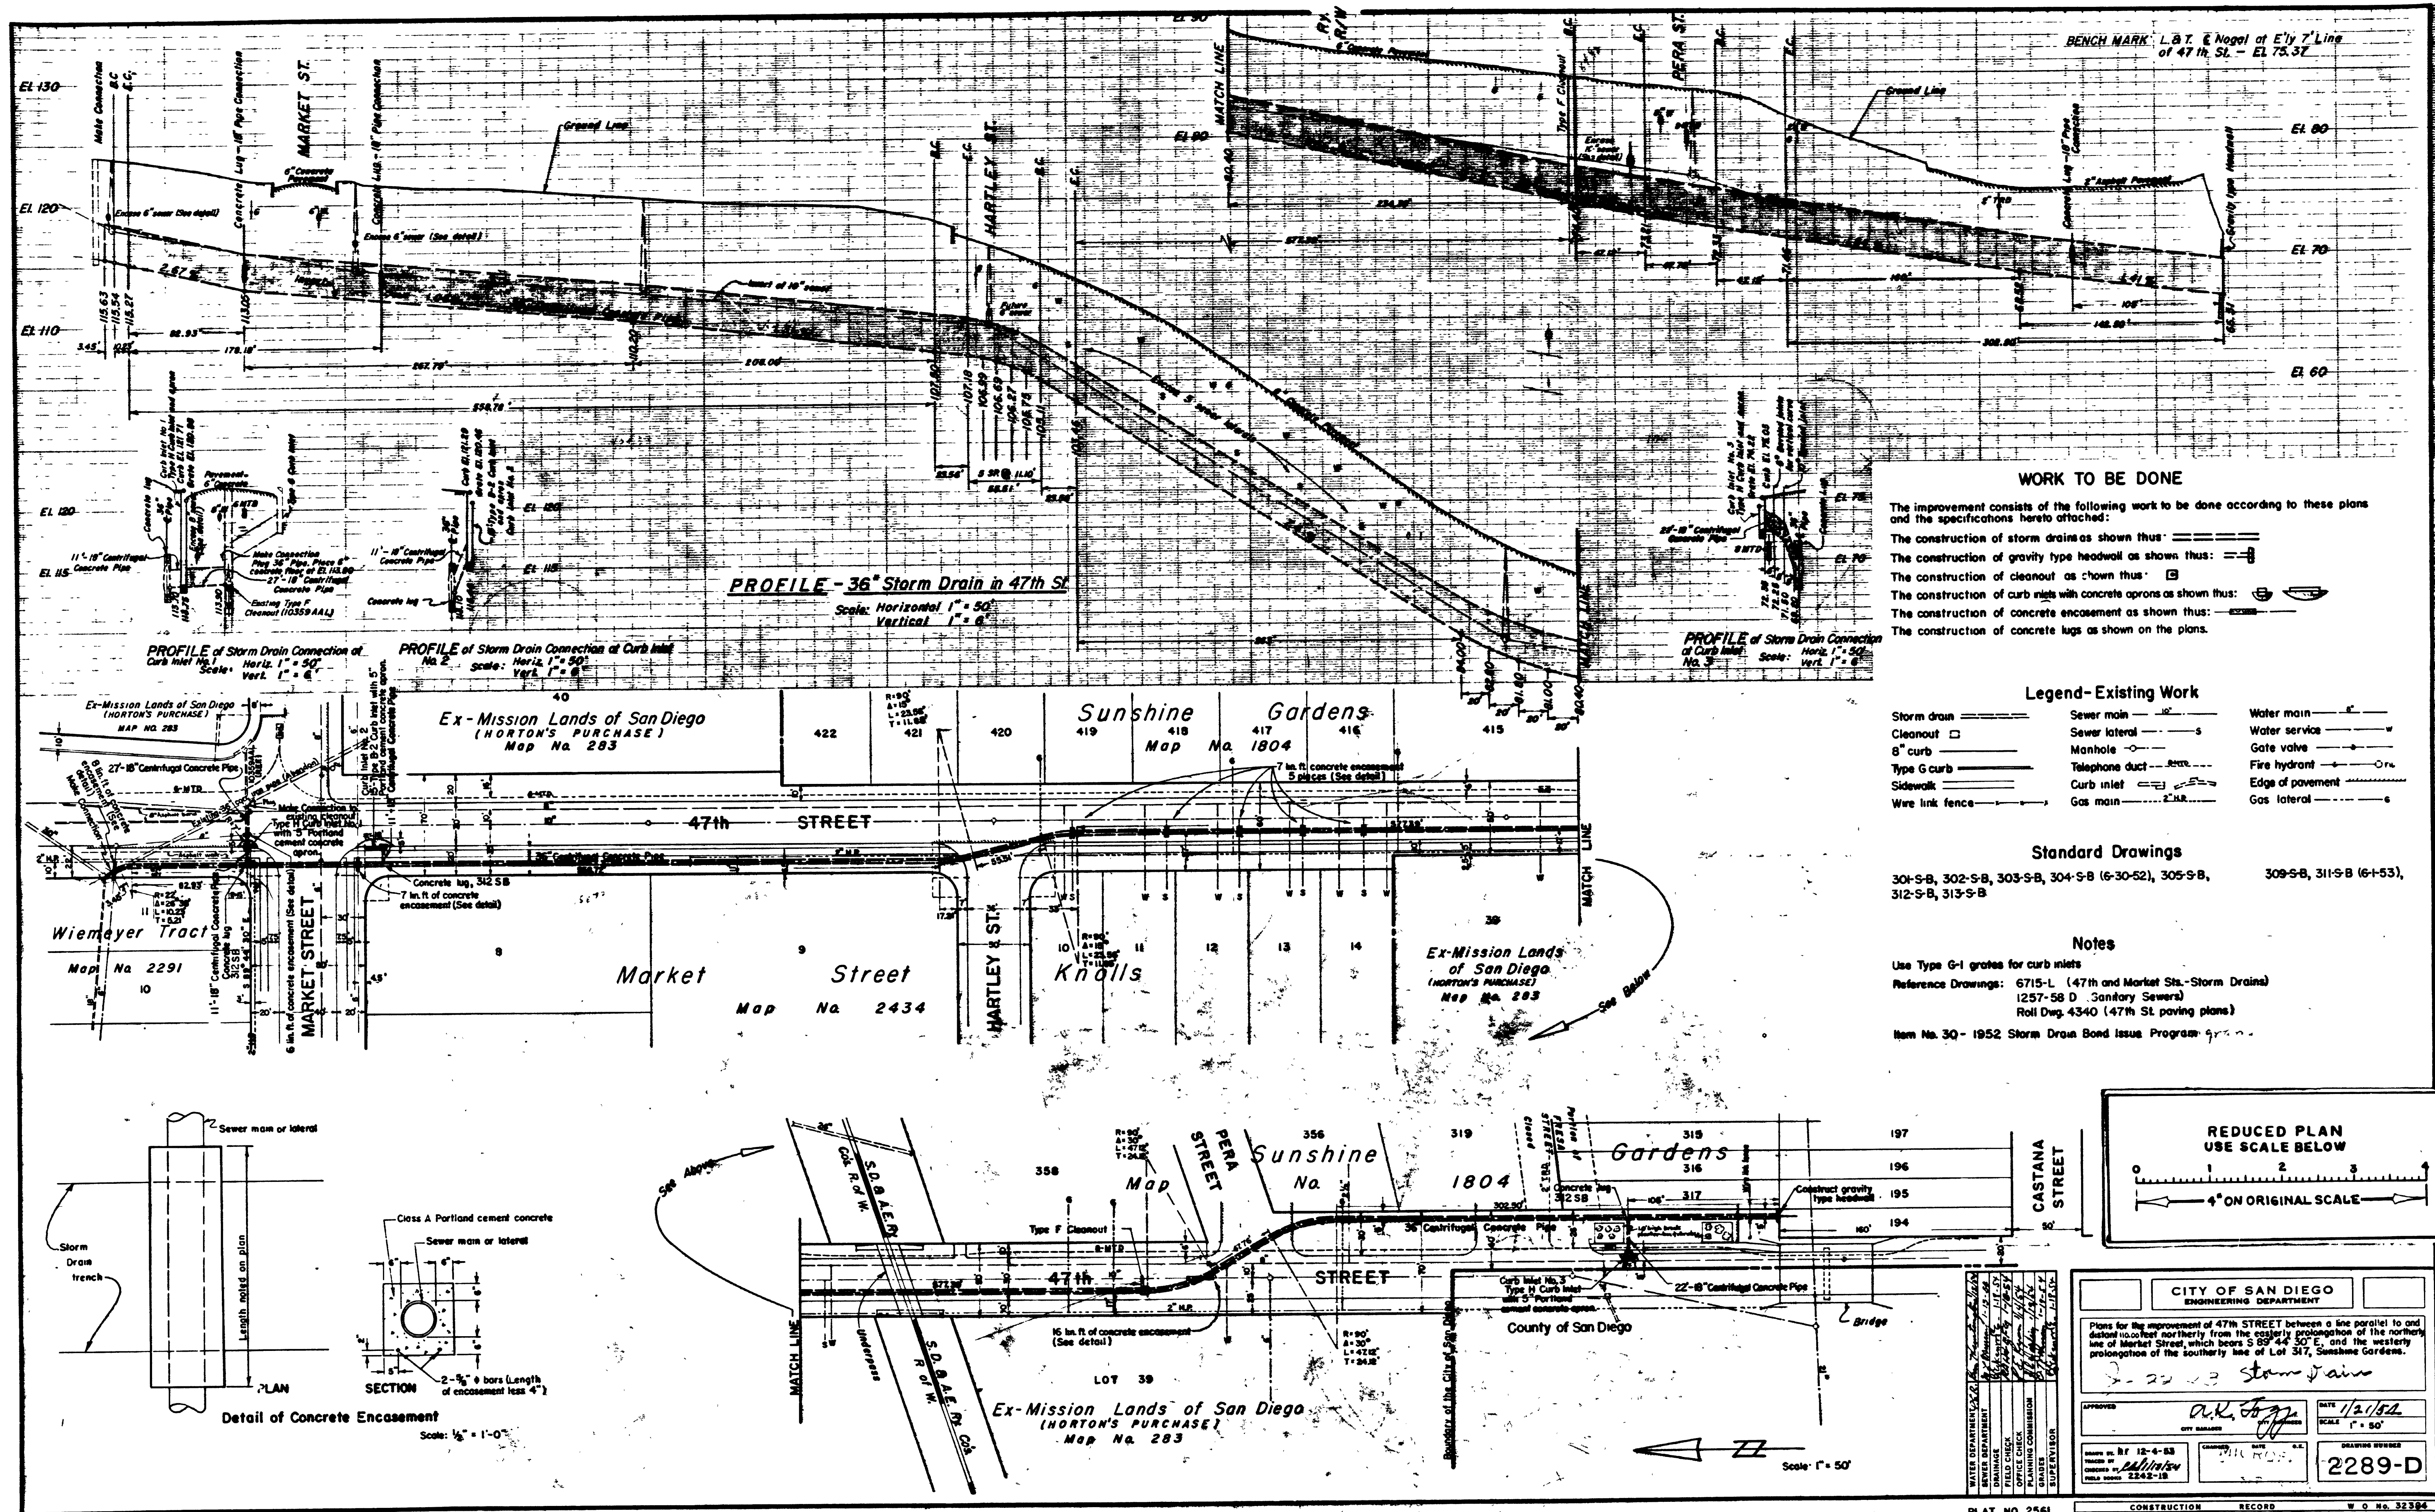

PLAT NO. 2561

CONSTRUCTION RECORD W. O. No. 32384

2485