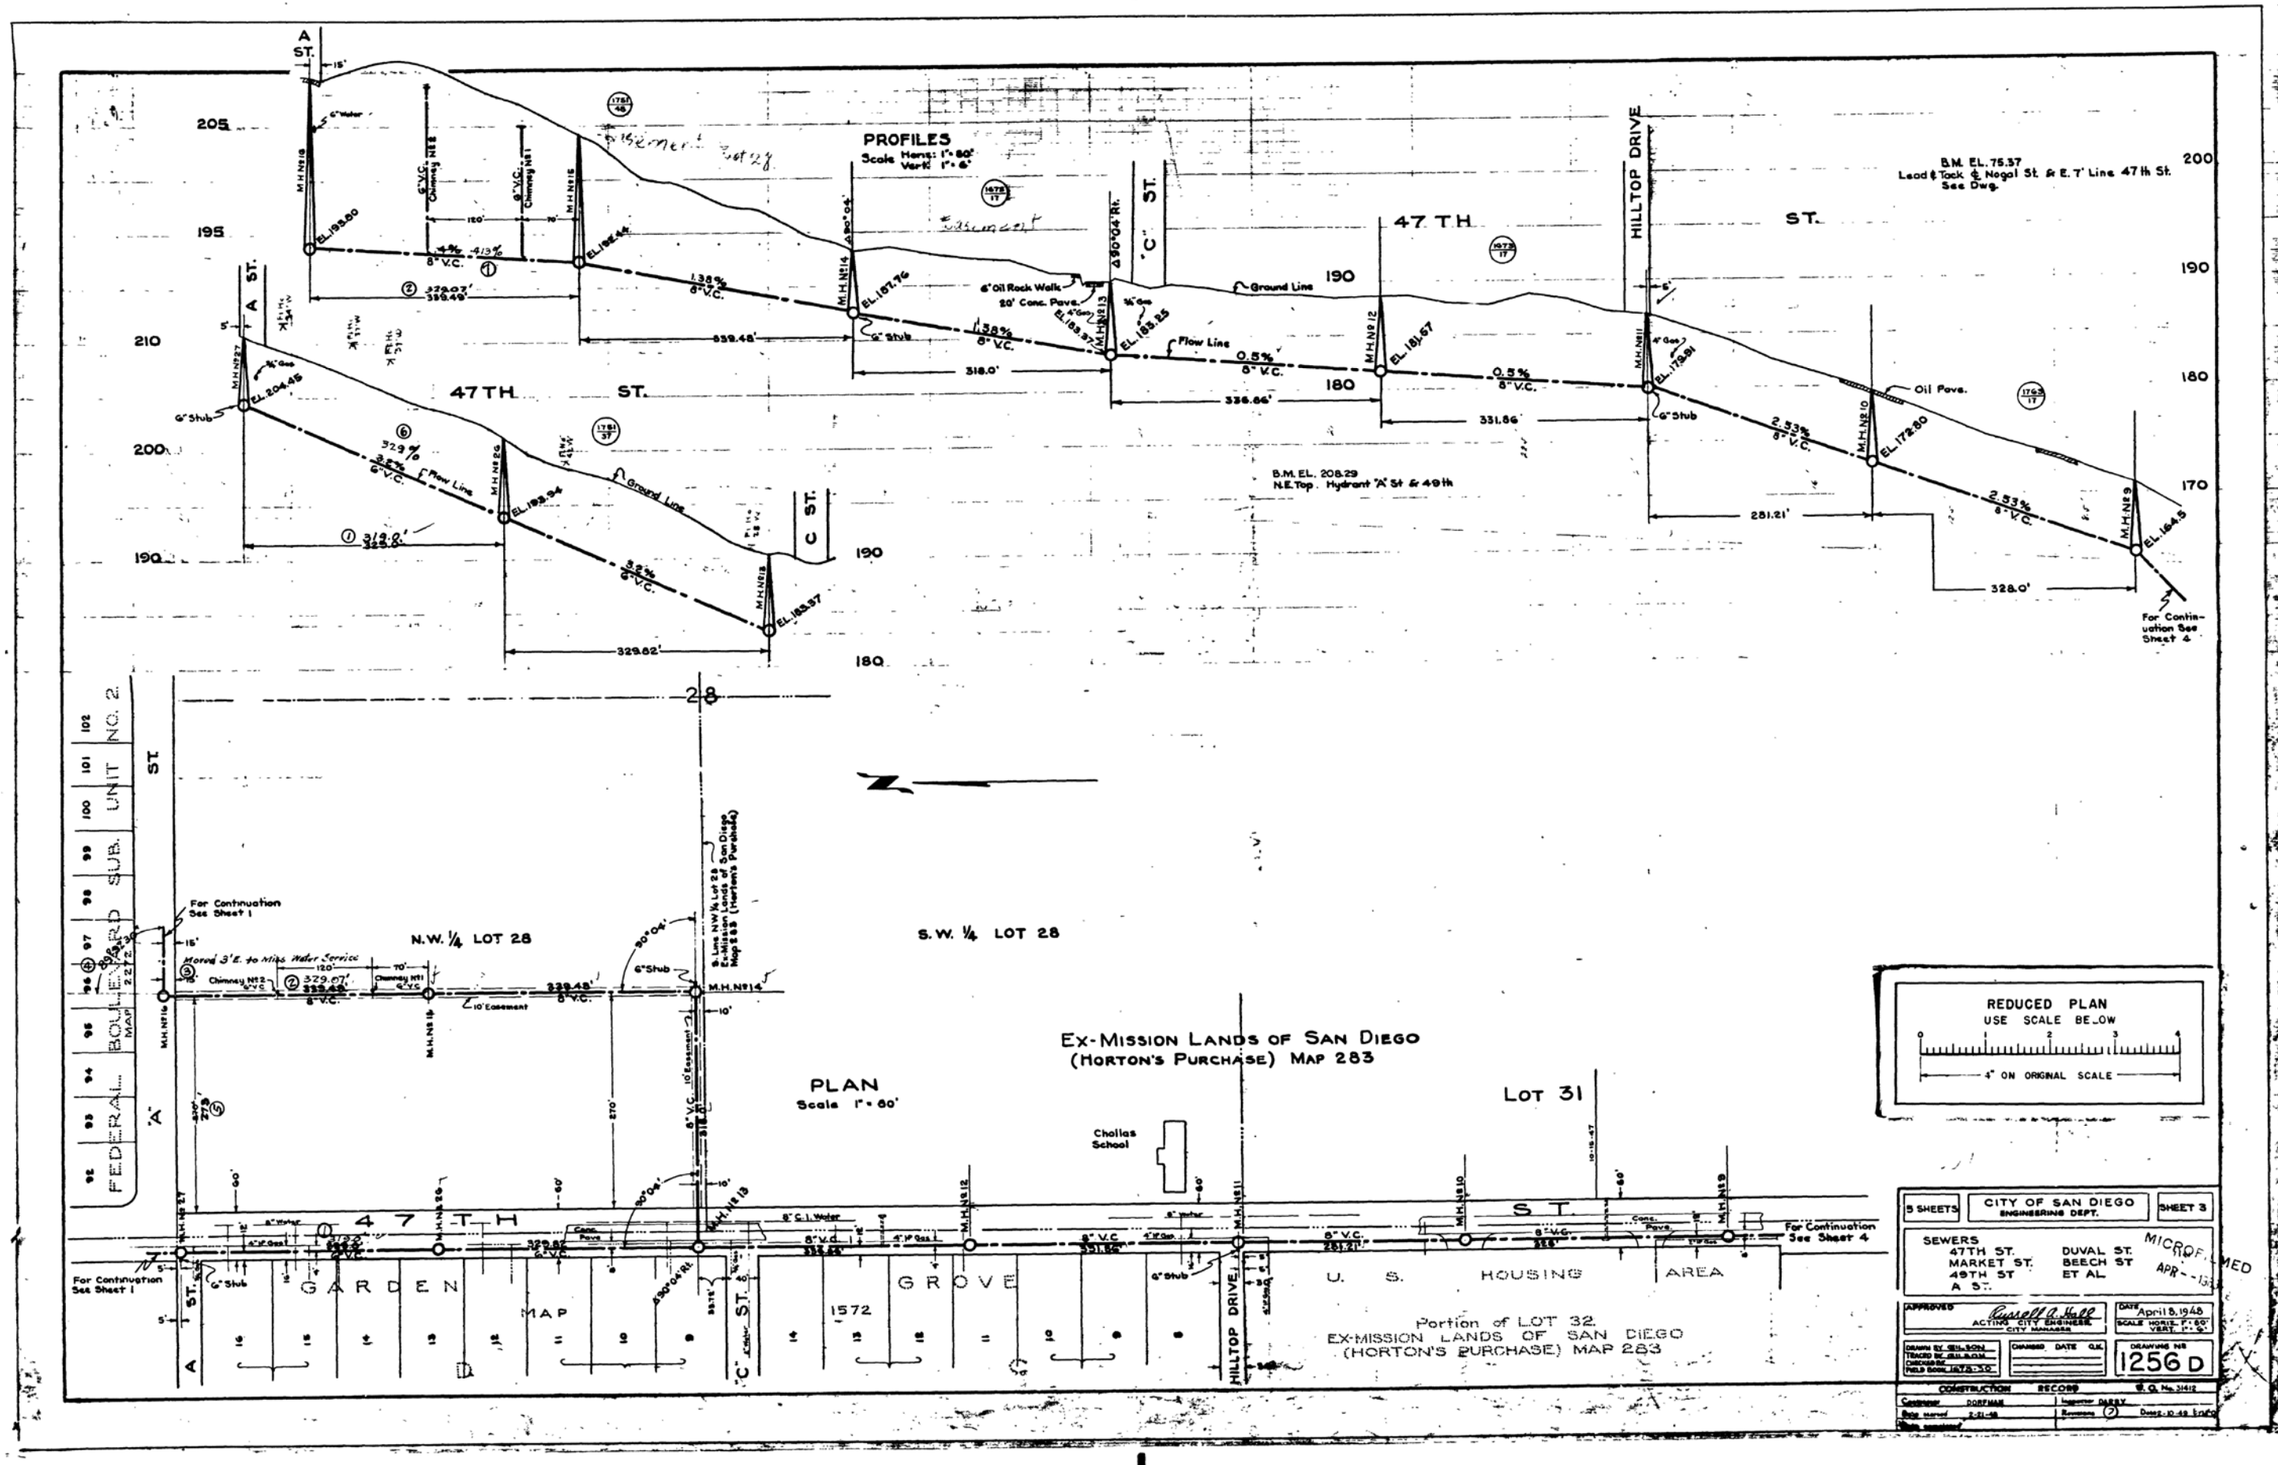
PROFILES
Scale Horiz: 1" = 80'
Vert: 1" = 6'
A ST.
47TH ST.
C ST.
HILLTOP DRIVE
B.M. EL. 75.37
Lead & Tack & Nogal St. & E. T' Line 47th St.
See Dwg.
B.M. EL. 208.29
N.E. Top. Hydrant 'A' St & 49th
Ground Line
Flow Line
Oil Pave.
For Continuation See Sheet 4
PLAN
Scale 1" = 60'
N.W. ¼ LOT 28
S.W. ¼ LOT 28
EX-MISSION LANDS OF SAN DIEGO
(HORTON'S PURCHASE) MAP 283
LOT 31
Chollas School
GARDEN GROVE
U. S. HOUSING AREA
Portion of LOT 32
EX-MISSION LANDS OF SAN DIEGO
(HORTON'S PURCHASE) MAP 283
FEDERAL BOULEVARD SUB. UNIT NO. 2
MAP 2272
For Continuation See Sheet 1
REDUCED PLAN
USE SCALE BELOW
4" ON ORIGINAL SCALE
5 SHEETS
CITY OF SAN DIEGO
ENGINEERING DEPT.
SHEET 3
SEWERS
47TH ST.
MARKET ST.
49TH ST
A ST.
DUVAL ST.
BEECH ST
ET AL.
APPROVED
Russell A. Hall
ACTING CITY ENGINEER
ACTING CITY MANAGER
DATE April 8, 1948
SCALE HORIZ. 1" = 60'
VERT. 1" = 6'
DRAWN BY
TRACED BY
CHECKED BY
FIELD BOOK
CHANGED
DATE
CK.
DRAWING NO
1256 D
CONSTRUCTION RECORD
W. O. No. 31412
Contractor DORFMAN
Date started 2-21-48
Inspector DERBY
Revisions (7)
Date completed
MICROFILMED
APR 1 13