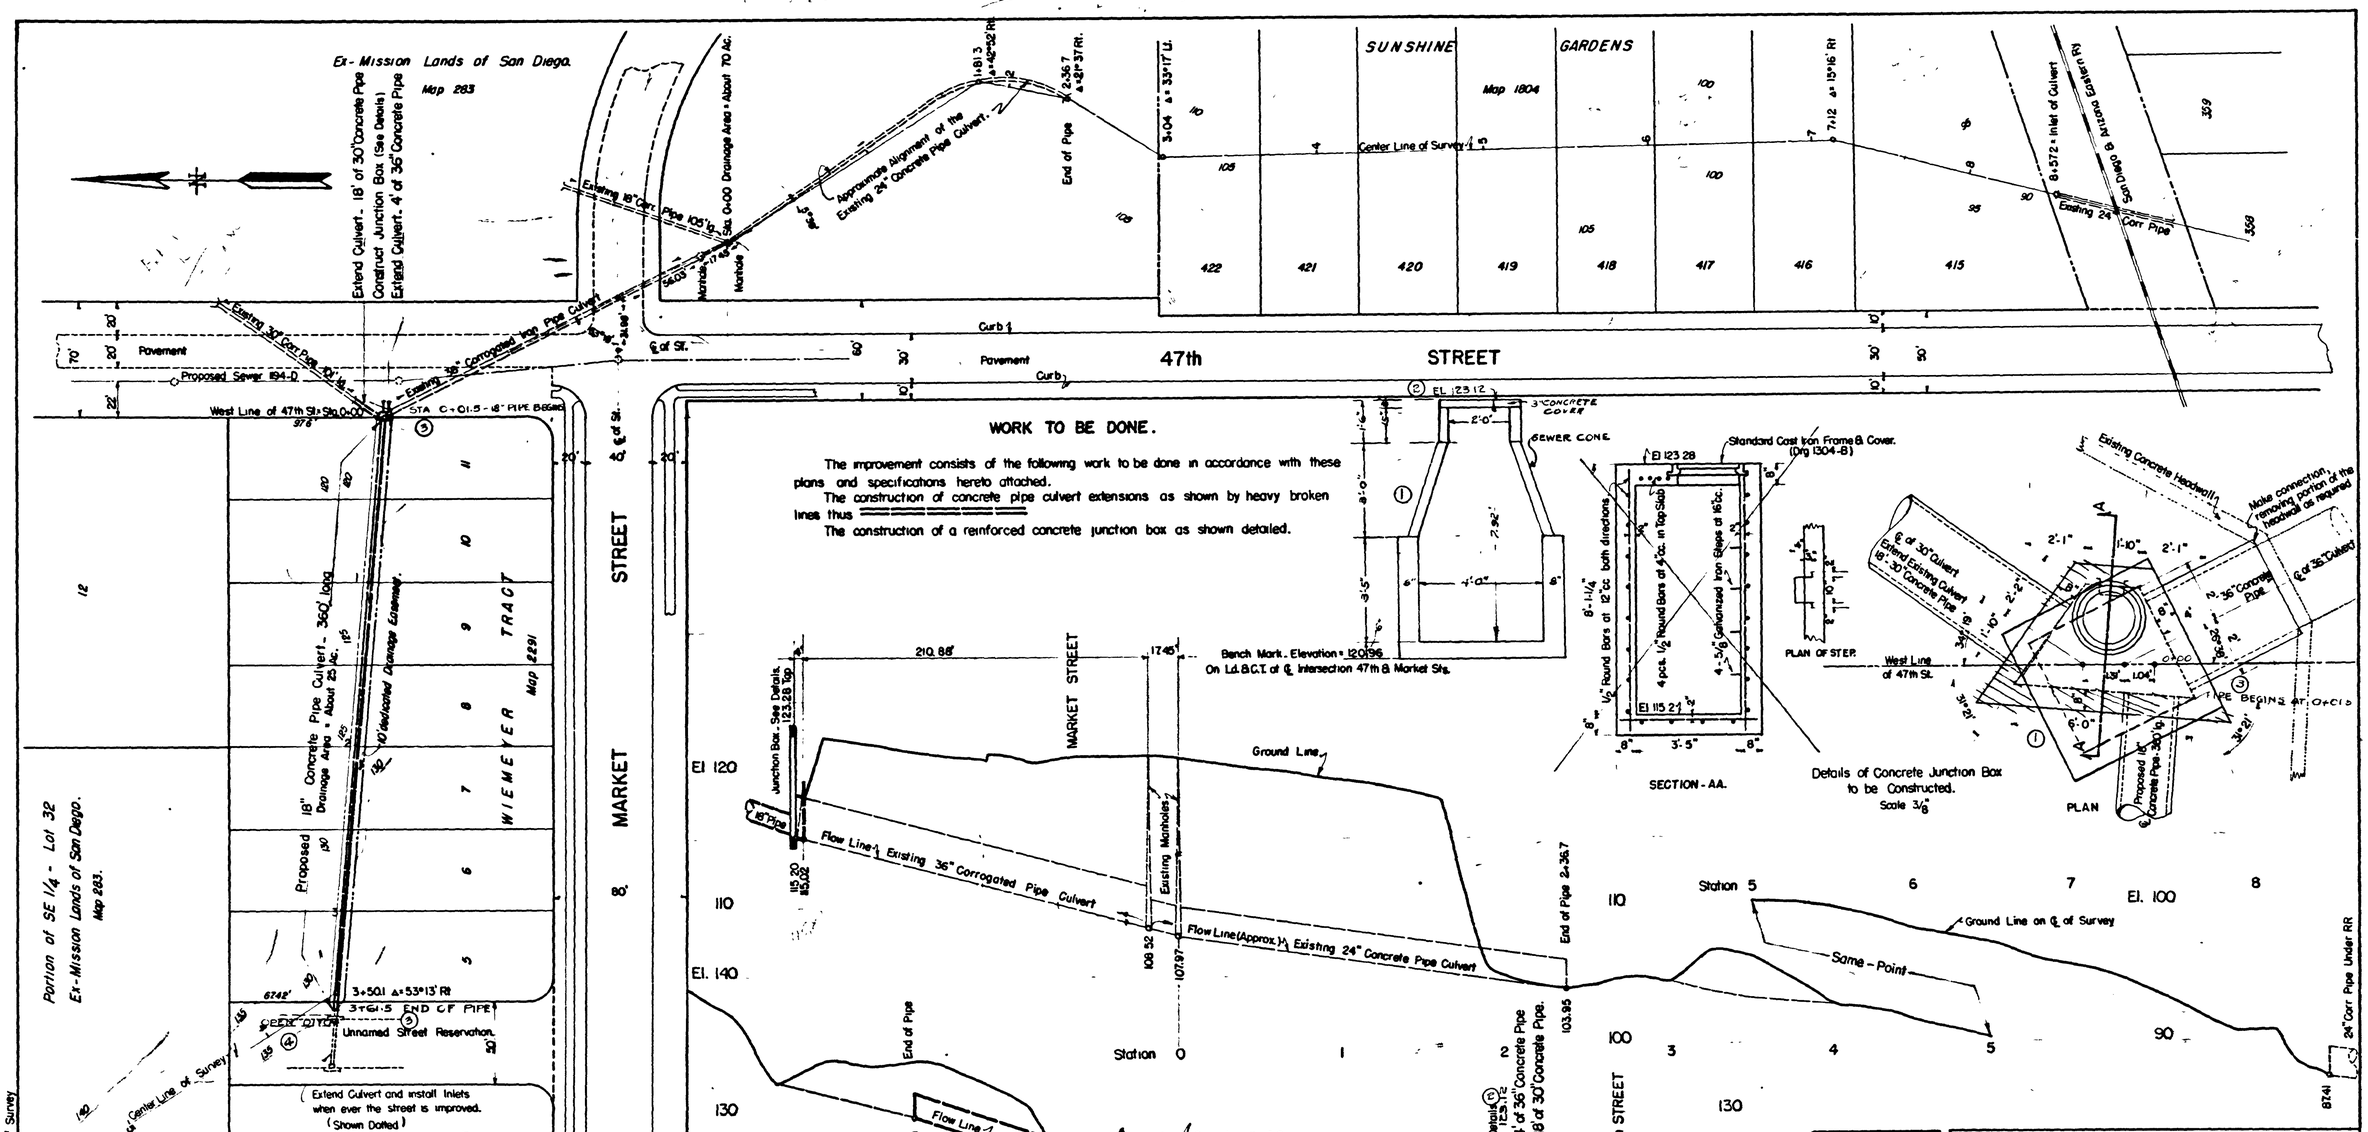


## NOTES.

The concrete pipe shall be Hume Centrifugal Concrete Pipe as manufactured by the American Pipe & Construction Company, or equal, and having "D" Load Classification = 1250 "D", or more, and conforming to the specifications in Document Number 353878 on file in the office of the City Clerk of San Diego.

All concrete shall be 1 2 4 mix

All reinforcing shall be deformed steel bars